IREDELL COUNTY HEALTH DEPARTMENT

STATESVILLE 704-878-5305 50.00 Paid MOORESVILLE 704-664-5281

IMPROVEMENT PERMIT / AUTHORIZATION TO CONSTRUCT / OPERATION PERMIT / EXISTING SYSTEM INSPECTION

PERMIT# 103379 PIN# 4676-99-1999 DATE 1/15/02

OWNER OR CONTRACTOR Shaverders Dev. / Randall Painter PHONE: Business 704-201-4621 Home

ADDRESS 1143-D Executive Dr. Cary NC 27511

LOCATION Brawley Sch / TR Bluing, TL Beaton Path, TL Circle, TL Shaverders, TL Beaton Path on LT

SUBDIVISION Shaverders Bluff BLOCK / SECTION LOT 70 LOT AREA 1.19AC SITE CLASS PS DESIGN FLOW 480 L.T.A.R. 0.3

Septic Tank: 1000 Gallons; STB 354 Date 9/17/01

Pump Tank: Gallons; PT Date

Pump Make: Model Serial No.

Nitrification Field: No Fields 1 Square Feet 1600 Linear Feet 535

No Lines 5@107' Trench Width 36" Max Trench Bottom Depth 36" Gravel Depth 12"

☒ New System ☐ Repair System Type: I II III IV V VI

System Description: Gravity Conventional

Repair System Description: Gravity / Pump 25% Red.

Maintenance Agreement Required: ☐ Yes ☒ No

☒ House/Mod. Home No. Bedrooms 4

☐ Mobile Home No. Bathrooms 3½

☐ Business No. Employees

☐ Other

☐ Slab ☒ Crawl Space ☐ Basement w/plumbing ☐ Basement wo/plumbing


Water Supply: ☒ Individual ☐ Public ☐ Community

Comments:/Conditions:


Comments:/Conditions:

INITIAL SITE SKETCH

1" = 50'

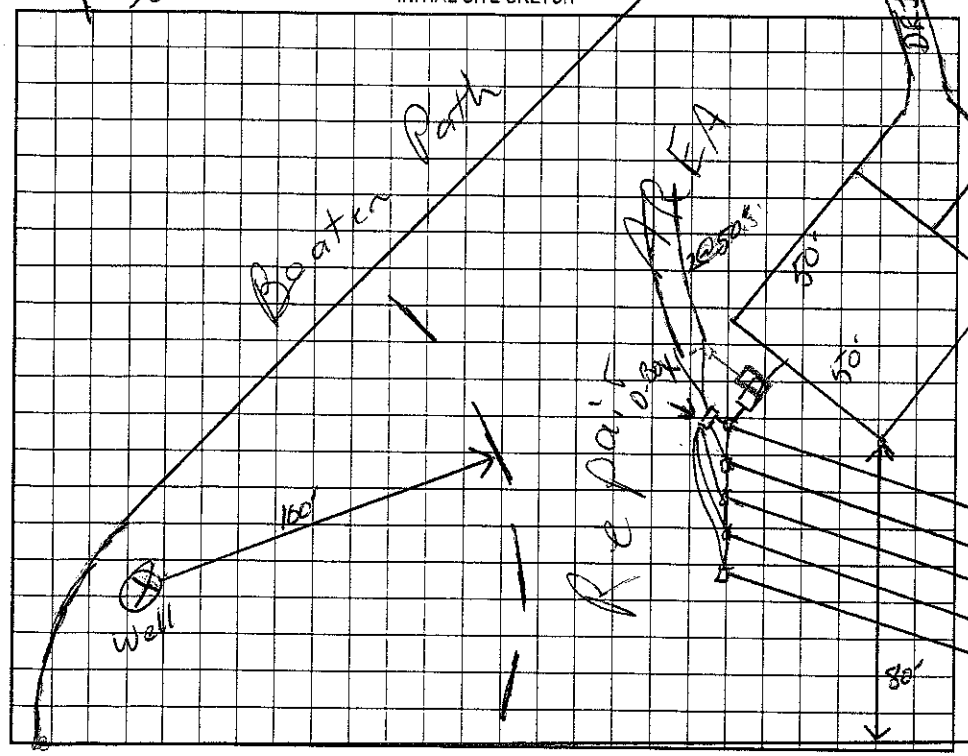

AS BUILT SKETCH

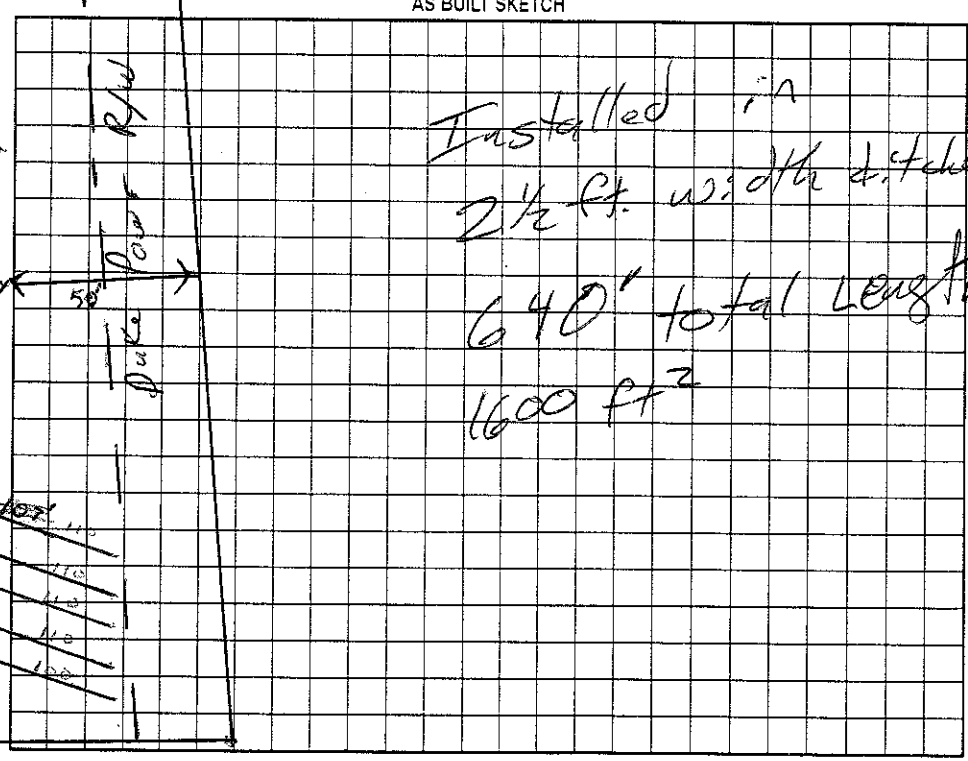

Permit can be suspended or revoked if any false information is supplied toward securing the permit/any unauthorized changes are made to the site/any unauthorized changes are made in the installation of the system. Improvement Permit with plat valid without expiration. Improvement Permit with site plan valid for sixty months. Authorization to Construct is valid for a period equal to that of Improvement Permit – not to exceed sixty months.

Signed: [signature] date 1.15.01 Installed by: Macleod Const. Co.

Improvement Permit by: [signature] RS date 1/15/02 Operation Permit by: [signature] RS date 6/3/02

Authorization to Construct by: [signature] RS date 1/15/02 Existing System Inspection by: date

HEALTH DEPT. COPY: WHITE OWNER COPY (FINAL): YELLOW OWNER COPY (INITIAL): PINK