462699-6957 3500 Paid

IREDELL COUNTY HEALTH DEPARTMENT

STATESVILLE 704-878-5305 MOORESVILLE 704-664-5281

IMPROVEMENT PERMIT / AUTHORIZATION TO CONSTRUCT / OPERATION PERMIT / EXISTING SYSTEM INSPECTION

PERMIT# 107347 PIN# ~~4627 96 9412 - 305~~ Kevin Huffstellar DATE Nov. 19, 02

OWNER OR CONTRACTOR Shavender Dev. Group PHONE: Business 361 8951 Home

ADDRESS 1143-D Executive Dr. / Cary, N.C. 27511

LOCATION Brawley Sch Rd. TR Blume TL Beaten Path TL Cicero TL Shavender TL Palmer Marsh on Right #134

SUBDIVISION Shavender's Bluff BLOCK / SECTION 3 LOT 305 LOT AREA 30,000 ft² SITE CLASS. PS DESIGN FLOW 480 gpd L.T.A.R. .25-.3

Septic Tank: 1000 Gallons; STB 1012 Date 3/21/05
Pump Tank: 1000 Gallons; PT 17 Date 6/28/05
Pump Make: Goulds Model WE0511H Serial No.
Nitrification Field: No Fields 1 Square Feet 640/960 Linear Feet 320
No Lines 5 Trench Width 24" min 8' oc Max Trench Bottom Depth 36" Gravel Depth NA

☑ New System ☐ Repair System Type: I. II. III. Ⓘ V. VI
System Description: LPP/PBPS
Repair System Description: LPP/PBPS
Maintenance Agreement Required: ☑ Yes ☐ No Aug 9 (?) '04

☐ Slab ☑ Crawl Space ☑ Basement w/plumbing ☐ Basement wo/plumbing

☑ House/Mod. Home No. Bedrooms 4
☐ Mobile Home No. Bathrooms 4
☐ Business No. Employees
☐ Other


Water Supply: ☑ Individual ☐ Public ☐ Community

Comments:/Conditions: OK 36" max 8' oc
OK to install system in 4 Laterals.
Tanks & lines checked by WS. 9/20/05

Comments:/Conditions: Checked pressure 10/12/05 MD
Elect & alarm

1" = 50'

INITIAL SITE SKETCH

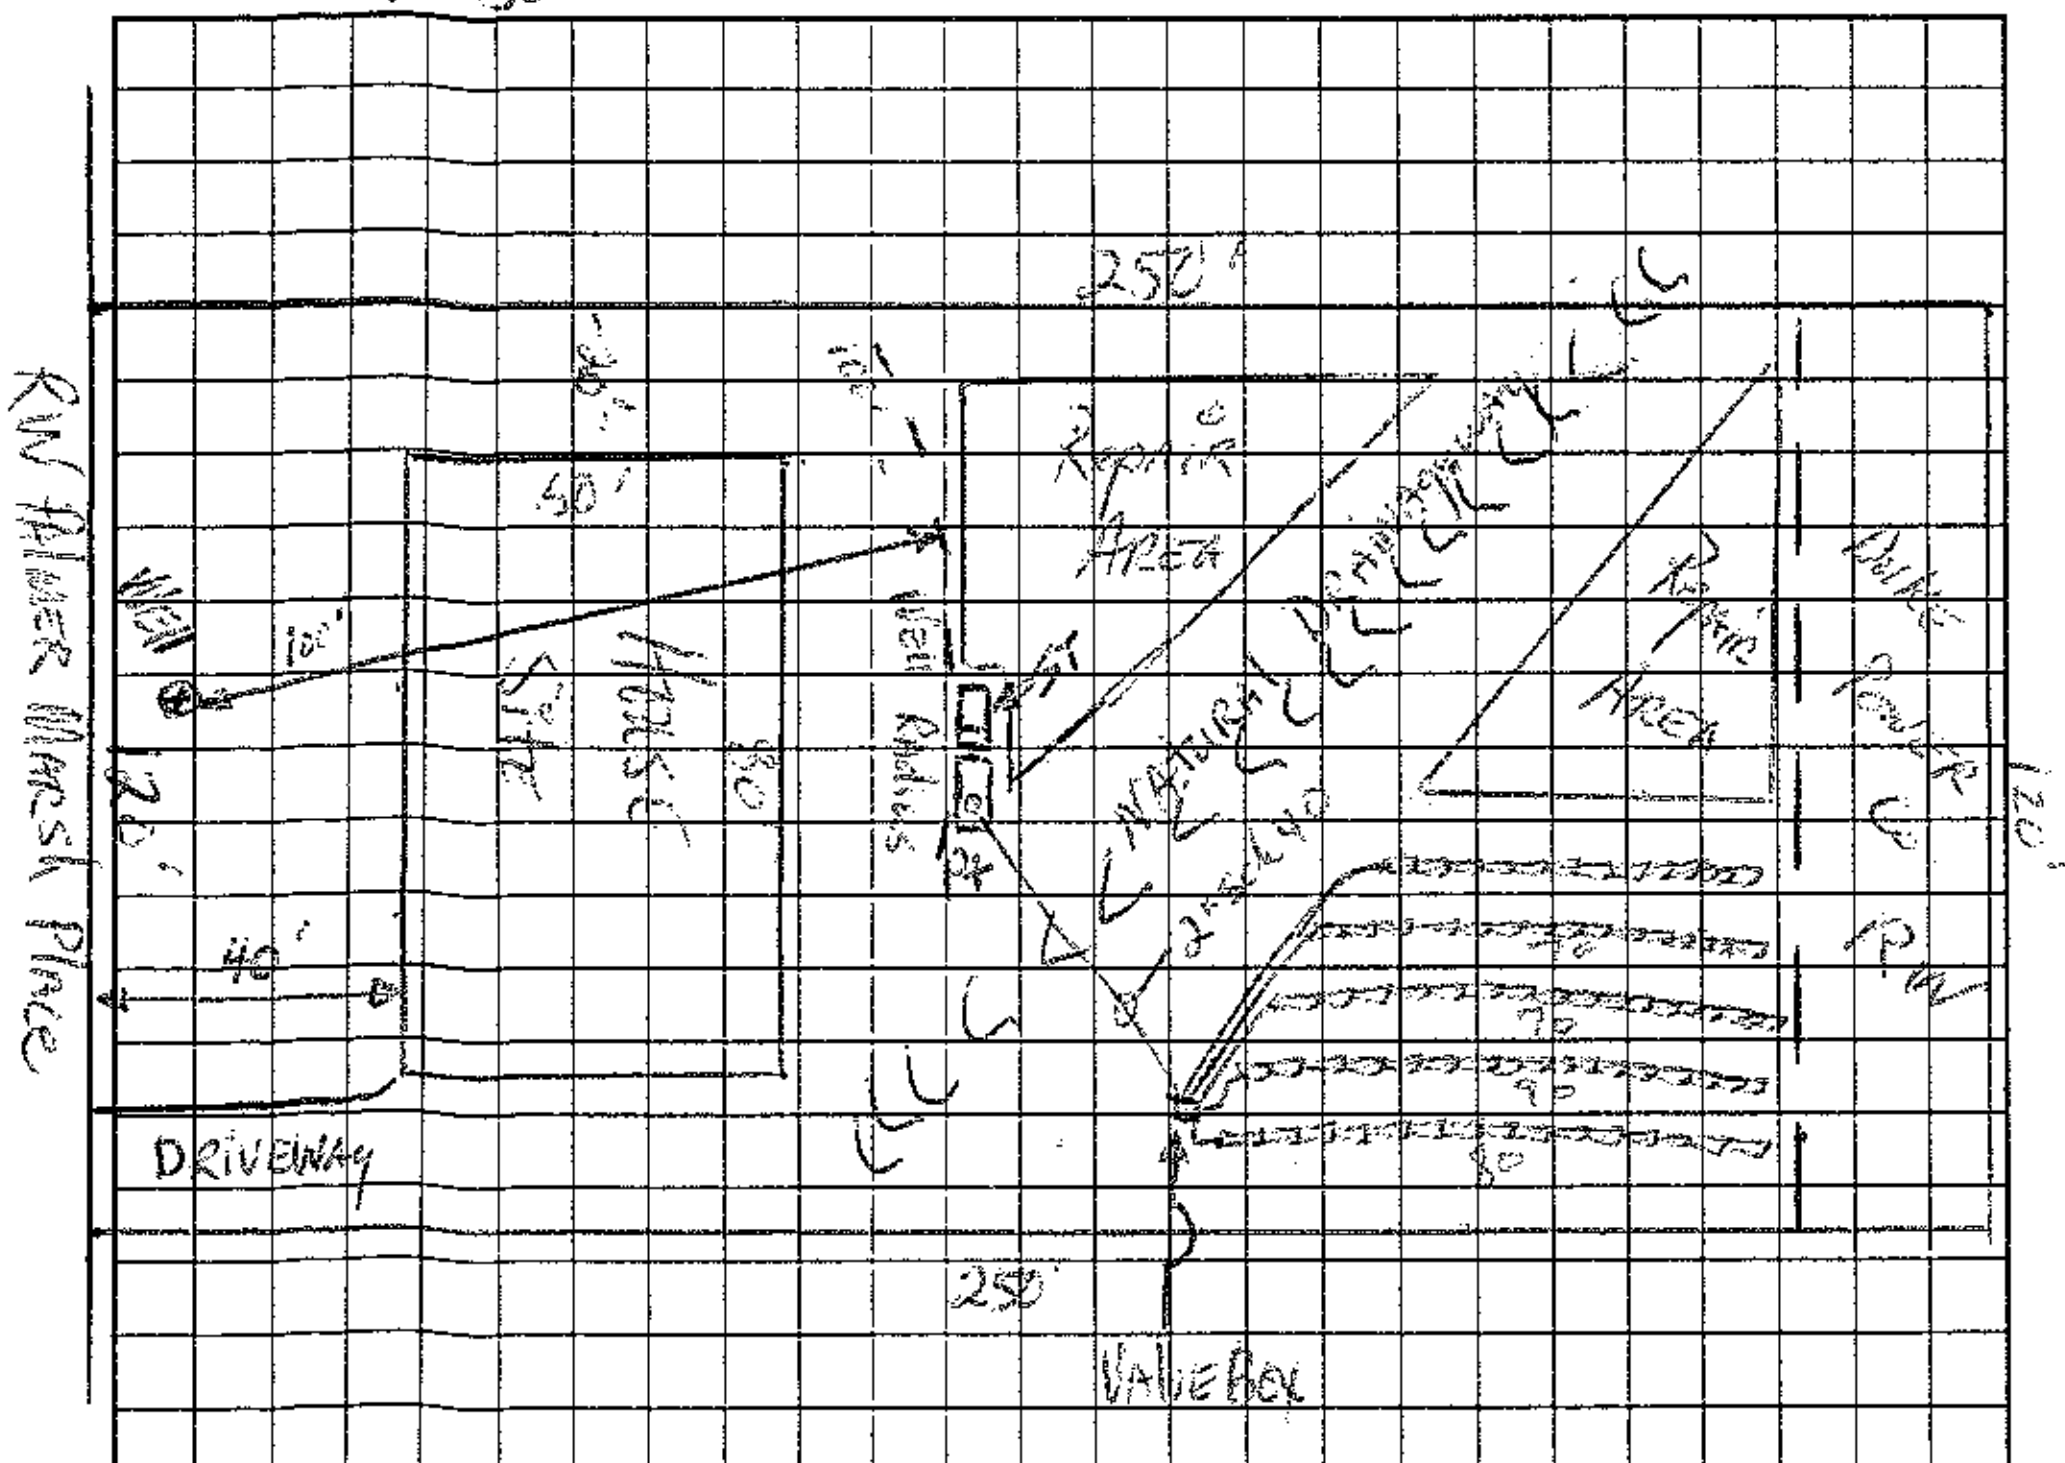

AS BUILT SKETCH

Permit can be suspended or revoked if any false information is supplied toward securing the permit/any unauthorized changes are made to the site/any unauthorized changes are made in the installation of the system. Improvement Permit with plat valid without expiration. Improvement Permit with site plan valid for sixty months. Authorization to Construct is valid for a period equal to that of Improvement Permit – not to exceed sixty months.

Signed: [signature] date 3-7-03
Improvement Permit by: [signature] RS date 11-19-02
Authorization to Construct by: Wesley Sparks RS date 9/7/04

Installed by: C & S
Operation Permit by: Maria H. Dobson RS date 10/14/05
Existing System Inspection by: date

HEALTH DEPT. COPY: WHITE OWNER COPY (FINAL): YELLOW OWNER COPY (INITIAL): PINK