IREDELL COUNTY HEALTH DEPARTMENT

ATESVILLE 704-878-5305 MOORESVILLE 704-664-5281

IMPROVEMENT PERMIT / AUTHORIZATION TO CONSTRUCT / OPERATION PERMIT / EXISTING SYSTEM INSPECTION

525.00 Tgd 3:00

PERMIT# 125617 PIN# 4627007686 799-1856 ext#3 DATE 1-18-05

OWNER OR CONTRACTOR Brian Jones / Kent Shaw PHONE: Business 261-6930 Home 704 201-6930

ADDRESS 105 Kilborne Rd Mooresville NC 28117

LOCATION McKendree Rd TR Lake View Shores Loop TL Abbot TR Lake View Shores TL Courtney

SUBDIVISION CL & T BLOCK / SECTION 8 LOT 283 LOT AREA .70 Acre SITE CLASS. PS DESIGN FLOW 480 gpd L.T.A.R. .3 Total of 4

Septic Tank: 1000 Gallons; STB 825 Date 10-17-05
Pump Tank: 1000 Gallons; PT 302 Date 11-3-05
Pump Make: Zoeller Model N140-C Serial No.
Nitrification Field: No Fields 1 Square Feet 534' Linear Feet 267'
No Lines 5 Trench Width 24" Max Trench Bottom Depth 30"-36" Gravel Depth N/A

☒ New System ☐ Repair System Type: I, II, III, IV, V, VI
System Description: Pump-LP-Panel Block
Repair System Description: Deeded prior to 1983
Maintenance Agreement Required: ☐ Yes ☐ No

☒ House/Mod. Home ☐ Mobile Home ☐ Business ☐ Other
No. Bedrooms 4 No. Bathrooms 3 No. Employees

Water Supply: ☒ Individual ☐ Public ☐ Community


☐ Slab ☐ Crawl Space ☒ Basement w/plumbing ☐ Basement wo/plumbing

Comments:/Conditions: Keep Septic System 10' from PL, 50' From lake & 50' to well. Stay 25' From Foundation drain Supply line-Sleeve under dave or bury >30"

Comments:/Conditions: ☒ Note: Must properly abandoned existing well prior to installation of new Septic System. Drilled 3/16" shale

Scale: 1:40

INITIAL SITE SKETCH PL 211

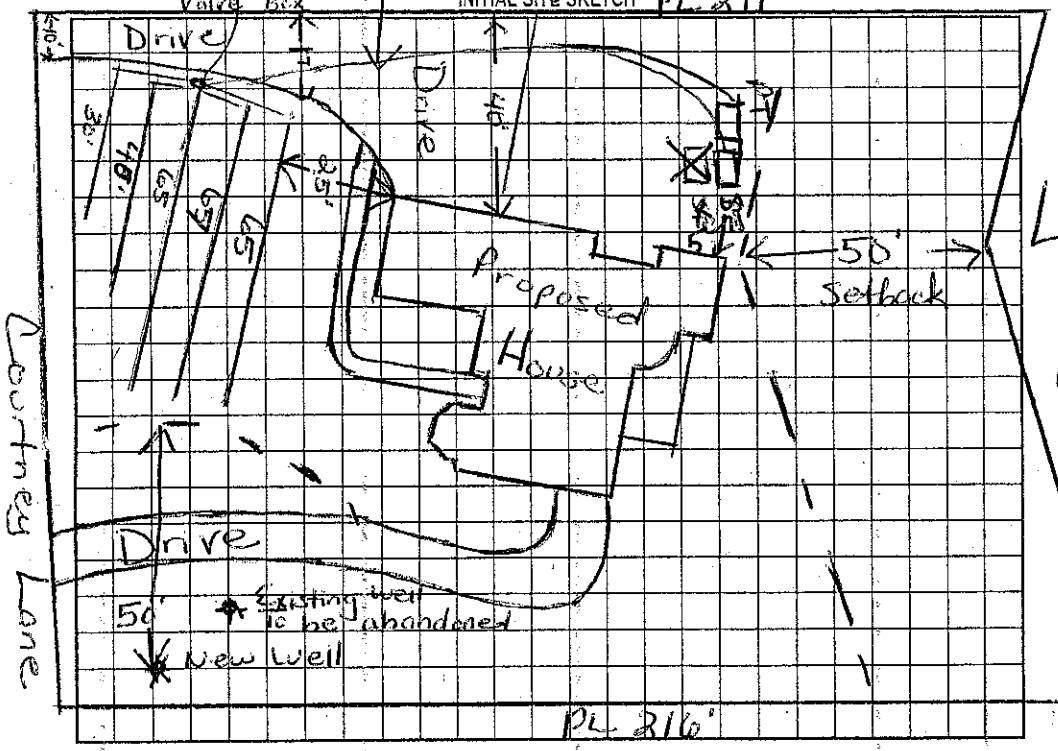

AS BUILT SKETCH

Tanks, lines & pressure checked 1/12/06

The proposed / existing Finishing basement room addition does not appear to impact the existing septic system.
**NOTE: total # of bedrooms = 4 Can not exceed 4 Bedrooms

Maria H. Dotson REHS
Date: 1/18/2010
ICHD-Environmental Health Division

Permit can be suspended or revoked if any false information is supplied toward securing the permit/any unauthorized changes are made to the site/any unauthorized changes are made in the installation of the system. Improvement Permit with plat valid without expiration. Improvement Permit with site plan valid for sixty months. Authorization to Construct is valid for a period equal to that of Improvement Permit – not to exceed sixty months.

Signed: Brian Jones date 1/19/05 Installed by: Rowan Septic RS

Improvement Permit by: Maria H. Dotson RS date 1/18/05 Operation Permit by: Maria H. Dotson date 4/10/06

Authorization to Construct by: Maria H. Dotson RS date 1/18/05 Existing System Inspection by: date

HEALTH DEPT. COPY: WHITE OWNER COPY (FINAL): YELLOW OWNER COPY (INITIAL): PINK