Jim Kellman 704 287 1227

IREDELL COUNTY HEALTH DEPARTMENT

STATESVILLE 704-878-5305 MOORESVILLE 704-664-5281

IMPROVEMENT PERMIT / AUTHORIZATION TO CONSTRUCT / OPERATION PERMIT / EXISTING SYSTEM INSPECTION

PERMIT# 131708 PIN# 4627 00 9714 DATE 1/11/06

OWNER OR APPLICANT Gordon McCurry PHONE: Business 336 766 8511 Home

ADDRESS 117 Courtney Ln Mooresville, NC 28117

LOCATION Brawley School Rd @ McKendree @ Lakeview Shores @ Courtney 117 Courtney Ln

SUBDIVISION CL & T BLOCK / SECTION 8 LOT 282 LOT AREA .79 acres SITE CLASS. PS DESIGN FLOW 360gpd L.T.A.R. .35 - .3

Septic Tank: 1000 Gallons; STB 1012 Date 7/31/99
Pump Tank: Gallons; PT Date
Pump Make: Model Serial No.
Nitrification Field: No Fields 1 Square Feet 960' Linear Feet 320'
No Lines 3 Trench Width 36" Max Trench Bottom Depth 36" Gravel Depth 12" ☒ Gravity ☐ Pressure

☐ New System ☐ Repair ☐ Expansion System Type: I (II) III IV V VI
System Description: Conventional
Repair System Description: LA PPBPS - Limit 40 .1945
Maintenance Agreement Required: ☐ Yes ☒ No

☒ House/Mod. Home No. Bedrooms 3
☐ Mobile Home No. Persons
☐ Business No. Employees
☐ Other


Water Supply: ☒ Individual ☐ Public ☐ Community

☐ Slab ☒ Crawl Space ☐ Basement w/plumbing ☐ Basement wo/plumbing

Comments:/Conditions:

Comments:/Conditions: existing SYS ✓ for House expansion.
No Bedrooms Added.

INITIAL SITE SKETCH

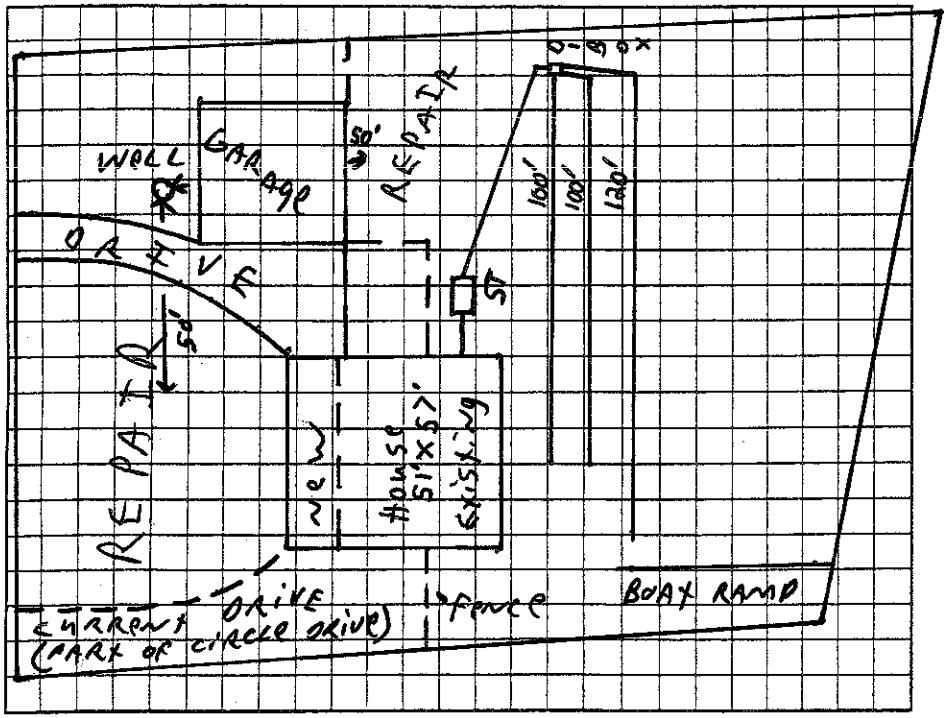

AS BUILT SKETCH

Permit can be suspended or revoked if any false information is supplied toward securing the permit/any unauthorized changes are made to the site/any unauthorized changes are made in the installation of the system. Improvement Permit with plat valid without expiration ☐ Improvement Permit with site plan valid for sixty months ☐ Authorization to Construct is valid for a period equal to that of Improvement Permit – not to exceed sixty months.

Signed: date 1/17/06

Improvement Permit by: date

Authorization to Construct by: date

Installed by:

Operation Permit by: date

Existing System Inspection by: date 1/11/06

HEALTH DEPT. COPY: WHITE OWNER COPY (FINAL): YELLOW OWNER COPY (INITIAL): PINK

IREDELL COUNTY HEALTH DEPARTMENT

STATESVILLE 704-878-5305 MOORESVILLE 704-664-5281

IMPROVEMENT PERMIT / AUTHORIZATION TO CONSTRUCT / OPERATION PERMIT / EXISTING SYSTEM INSPECTION

PERMIT# 082338 PIN# 4627009714 Curtis Batten-Contractor DATE 7/20/99

OWNER OR CONTRACTOR Gordon McCurry PHONE: Business (336) 382-2932 Home

ADDRESS P.O. Box 827 Clemmons NC 27012

LOCATION Brawley School Rd TR McKendree TR Lakeview TL Abbott TR Lakeview TL Courtleyon

SUBDIVISION Duke BLOCK / SECTION 8 LOT 282 LOT AREA .79 Acre SITE CLASS. PS DESIGN FLOW 360gpd L.T.A.R. .35 — .3 left

Septic Tank: 1000 Gallons; STB 1012 Date 7/31/99
Pump Tank: Gallons; PT Date
Pump Make: Model Serial No.
Nitrification Field: No Fields 1 Square Feet 1080' Linear Feet 360'+
No Lines 3 at 120'+ Trench Width 36" Max Trench Bottom Depth 36" Gravel Depth 12"

[X] New System [ ] Repair System Type: I, (II), III, IV, V, VI
System Description: Gravity — Conventional
Repair System Description: Pump-Modified
Maintenance Agreement Required: [ ] Yes [X] No

[X] House/Mod. Home No. Bedrooms 3
[ ] Mobile Home No. Bathrooms 2
[ ] Business No. Employees
[ ] Other


[ ] Slab [X] Crawl Space [ ] Basement w/plumbing [ ] Basement wo/plumbing

Water Supply: [X] Individual [ ] Public [ ] Community

Comments/Conditions: Keep Septic System at least 10' from PL 50' from lake & 50' from any well, 5' from House.

Comments/Conditions: Tank has riser & filter
Tank & lines checked 10/15/99 MD

INITIAL SITE SKETCH

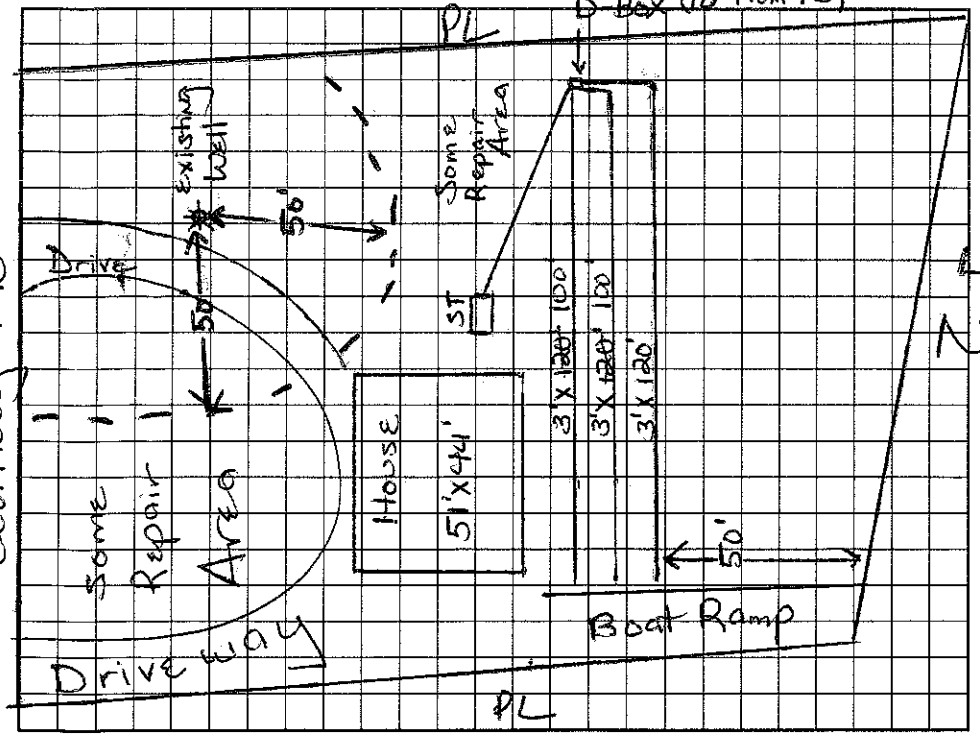

AS BUILT SKETCH

Permit can be suspended or revoked if any false information is supplied toward securing the permit/any unauthorized changes are made to the site/any unauthorized changes are made in the installation of the system. Improvement Permit with plat valid without expiration. Improvement Permit with site plan valid for sixty months. Authorization to Construct is valid for a period equal to that of Improvement Permit – not to exceed sixty months.

Signed: Curtis Batten date 7/28/99 Installed by: C & W Grading

Improvement Permit by: Maria H. Dotson RS date 7/20/99 Operation Permit by: Maria H. Dotson RS date 10/15/99

Authorization to Construct by: Maria H. Dotson RS date 7/20/99 Existing System Inspection by: date

HEALTH DEPT. COPY: WHITE OWNER COPY (FINAL): YELLOW OWNER COPY (INITIAL): PINK