IREDELL COUNTY HEALTH DEPARTMENT

Statesville Office (704) 878-5305 Mooresville Office (704) 660-3625 PERMIT # 210876

IMPROVEMENT PERMIT / AUTHORIZATION TO CONSTRUCT / OPERATION PERMIT / EXISTING SYSTEM

PIN # 4627-01-8061.000

APPLICANT: Moellman Group LLC APPLICANT ADDRESS: 412 Lakeview Shores Ln. Mooresville NC

SITE ADDRESS: 108 Courtney Ln. Mooresville NC PHONE: 704-287-1227 ALT. PHONE:

SITE DIRECTIONS: BSR, TR McKendree,

SUBDIVISION: CL & T SECTION: 8 LOT # 290 LOT AREA: .65 ACRE DESIGN FLOW: Ex. 240 GPD L.T.A.R.: Existing


Septic Tank	Existing	(gal)	STB		Date		☐ New System	☐ Repair	☐ Expansion	System Type: I	II	III	IV	V	VI	☒ Residence	No. Bedrooms Ex. 2	Water Supply
Pump Tank		(gal)	PT		Date		System Description: Existing Gravity Conventional Bed									☐ Business	No. Persons Ex. 4	☒ Private
Pump Make		Model			Serial #		Repair System Description: Existing									☐ Other	No. Employees	☐ Public
# Nitrification Fields	Ex.	# Lines	Existing Bed		Linear Ft:	Ex.	Maintenance Agreement Required:		☐ YES	☒ NO						☐ Slab	☐ Crawl Space	☐ Community
Trench Width	Ex.	Max. Trench Bottom Depth	Existing		Gravel Depth	Existing	☒ GRAVITY	☐ PRESSURE								☐ Basement w/plumbing	☒ Basement w/o plumbing	

Comments / Conditions: Systems Appeared To Be Functioning At Time Of Inspection. Deck Addition Already Constructed.

INITIAL SITE SKETCH

1" = 40'

AS BUILT SKETCH

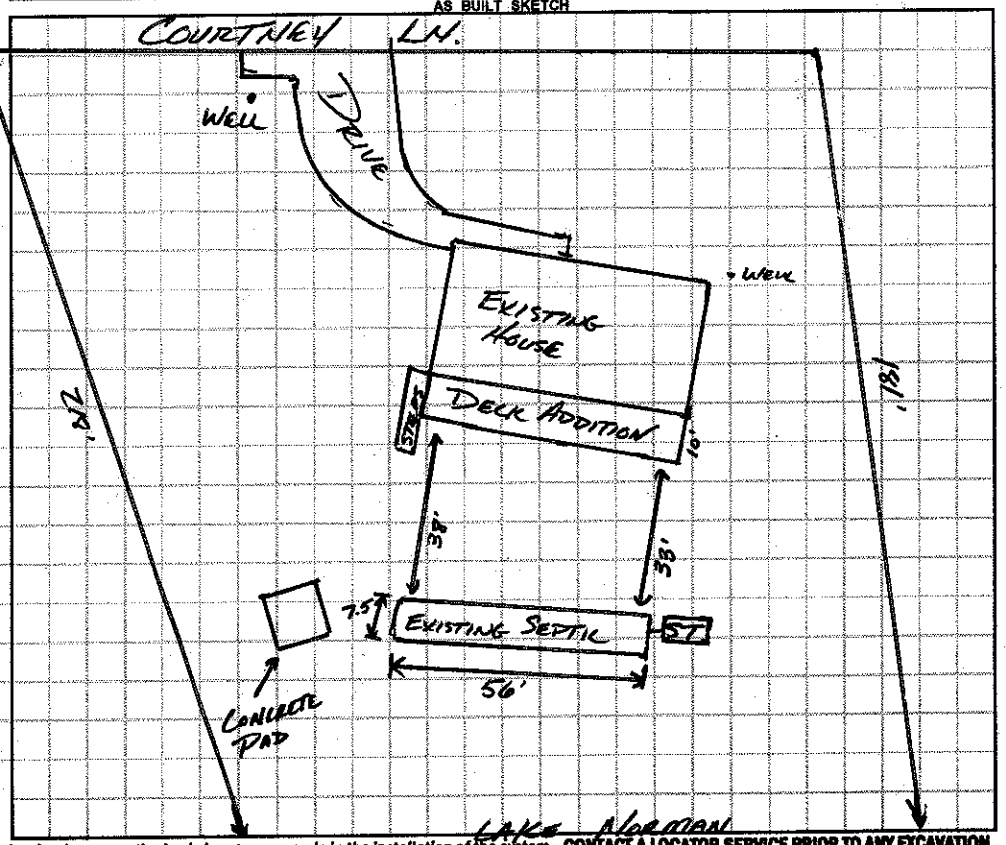

Permit can be suspended or revoked if any false information is supplied toward securing the permit / any unauthorized changes are made to the site / any unauthorized changes are made in the installation of the system. **CONTACT A LOCATOR SERVICE PRIOR TO ANY EXCAVATION**

☐ **IMPROVEMENT PERMIT** *with plat valid without expiration.* ☐ **IMPROVEMENT PERMIT** *with site plan valid for 60 mos.* ☐ **AUTHORIZATION TO CONSTRUCT** *valid for period equal to IMPROVEMENT PERMIT--not to exceed 60 mo.*

Owner / Applicant Signature: Date: 6/12/15 Installed by:

IMPROVEMENT PERMIT by: Date: OPERATION PERMIT by: Date:

AUTHORIZATION TO CONSTRUCT by: Date: Existing System Inspected by: Date: APPROVED MAY 29 2015

Health Dept. Copy - WHITE Applicant (Final Approval) - YELLOW Applicant (Conditional Approval) - PINK