IREDELL COUNTY HEALTH DEPARTMENT

Statesville Phone TR 3-7271 Mooresville Phone NO 3-1271

PERMIT TO INSTALL SEPTIC TANK

Permit No. 99 Permit Date 8-5- 1971

Owner Newton Address Chester, S.C.

Installed By J.R. Bowles Address Mooresville


Location of Property Sec 8 Lot 272

Tank		Capacity		Length of Lines		Fixtures	
Block	( )	1000	(✓)	225'	( )	No. of Baths	(✓)
Precast	(✓)	1250	( )	250'	( )	Dishwasher	( )
		1500	( )	Other 228		Garbage Grdr.	( )
		Other				Other	

NOTIFY HEALTH DEPARTMENT AT LEAST EIGHT HOURS BEFORE TANK IS TO BE INSPECTED.

Final Inspection 8-5- 1971 Approved (✓) Disapproved ( )

Remarks

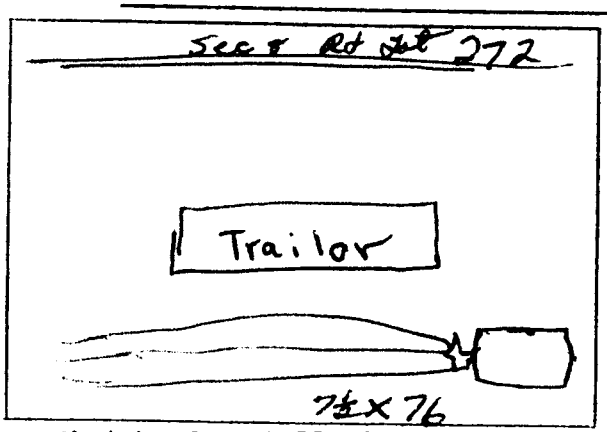

Sketch of Installation

J.C. Moore

Sanitarian

Lake