IREDELL COUNTY HEALTH DEPARTMENT

STATESVILLE 704-878-5305 — MOORESVILLE 704-664-5281

IMPROVEMENT PERMIT / AUTHORIZATION TO CONSTRUCT / OPERATION PERMIT / EXISTING SYSTEM INSPECTION

PERMIT# 131331 PIN# 4626071828.505

OWNER OR CONTRACTOR The Farms LLC DATE Sept 28, 05

ADDRESS 2214 Brawley Sch Rd, Mooresville, N.C. 28117 PHONE: Business (704) 660-1185 Home

LOCATION Brawley Sch Rd TR McKendree TR Lakeview Shores Loop TL Abbot TR Willow Bend Ct, at end on left

SUBDIVISION The Farms BLOCK / SECTION 4 LOT 505 LOT AREA 1.983ac SITE CLASS. PS DESIGN FLOW 480gpd L.T.A.R. .03

Septic Tank: 1000 gal Gallons; STB 444 Date 2-21-01

Pump Tank: Gallons; PT Date

Pump Make: Model Serial No.

Nitrification Field: No Fields 1 Square Feet 1215 Linear Feet 405

No Lines 3 Trench Width 36" Max Trench Bottom Depth 36" Gravel Depth NA

☒ New System ☐ Repair System Type: I, II, III, IV, V, VI

System Description: Gravity 25% Reduction Recycled

Repair System Description: LPPBPS

Maintenance Agreement Required: ☐ Yes ☒ No Initially

☒ House/Mod. Home ☐ Mobile Home ☐ Business ☐ Other

No. Bedrooms 4 No. Bathrooms No. Employees

☐ Slab ☒ Crawl Space ☐ Basement w/plumbing ☐ Basement wo/plumbing

Water Supply: ☐ Individual ☒ Public ☒ Community

Comments:/Conditions:

Approved site evaluation and system design performed by Paul Verzuniga and Kathleen Hawes @ Stanley Septic

Comments:/Conditions:

INITIAL SITE SKETCH

AS BUILT SKETCH

Permit can be suspended or revoked if any false information is supplied toward securing the permit/any unauthorized changes are made to the site/any unauthorized changes are made in the installation of the system. Improvement Permit with plat valid without expiration. Improvement Permit with site plan valid for sixty months. Authorization to Construct is valid for a period equal to that of Improvement Permit – not to exceed sixty months.

Signed: Kathleen Hawes date 9/30/05

Improvement Permit by: [signature] date 9-28-05


Authorization to Construct by: [signature] date 10-10-06

Installed by: Stanley Septic

Operation Permit by: [signature] date 5-8-07

Existing System Inspection by: date

HEALTH DEPT. COPY: WHITE OWNER COPY (FINAL): YELLOW OWNER COPY (INITIAL): PINK

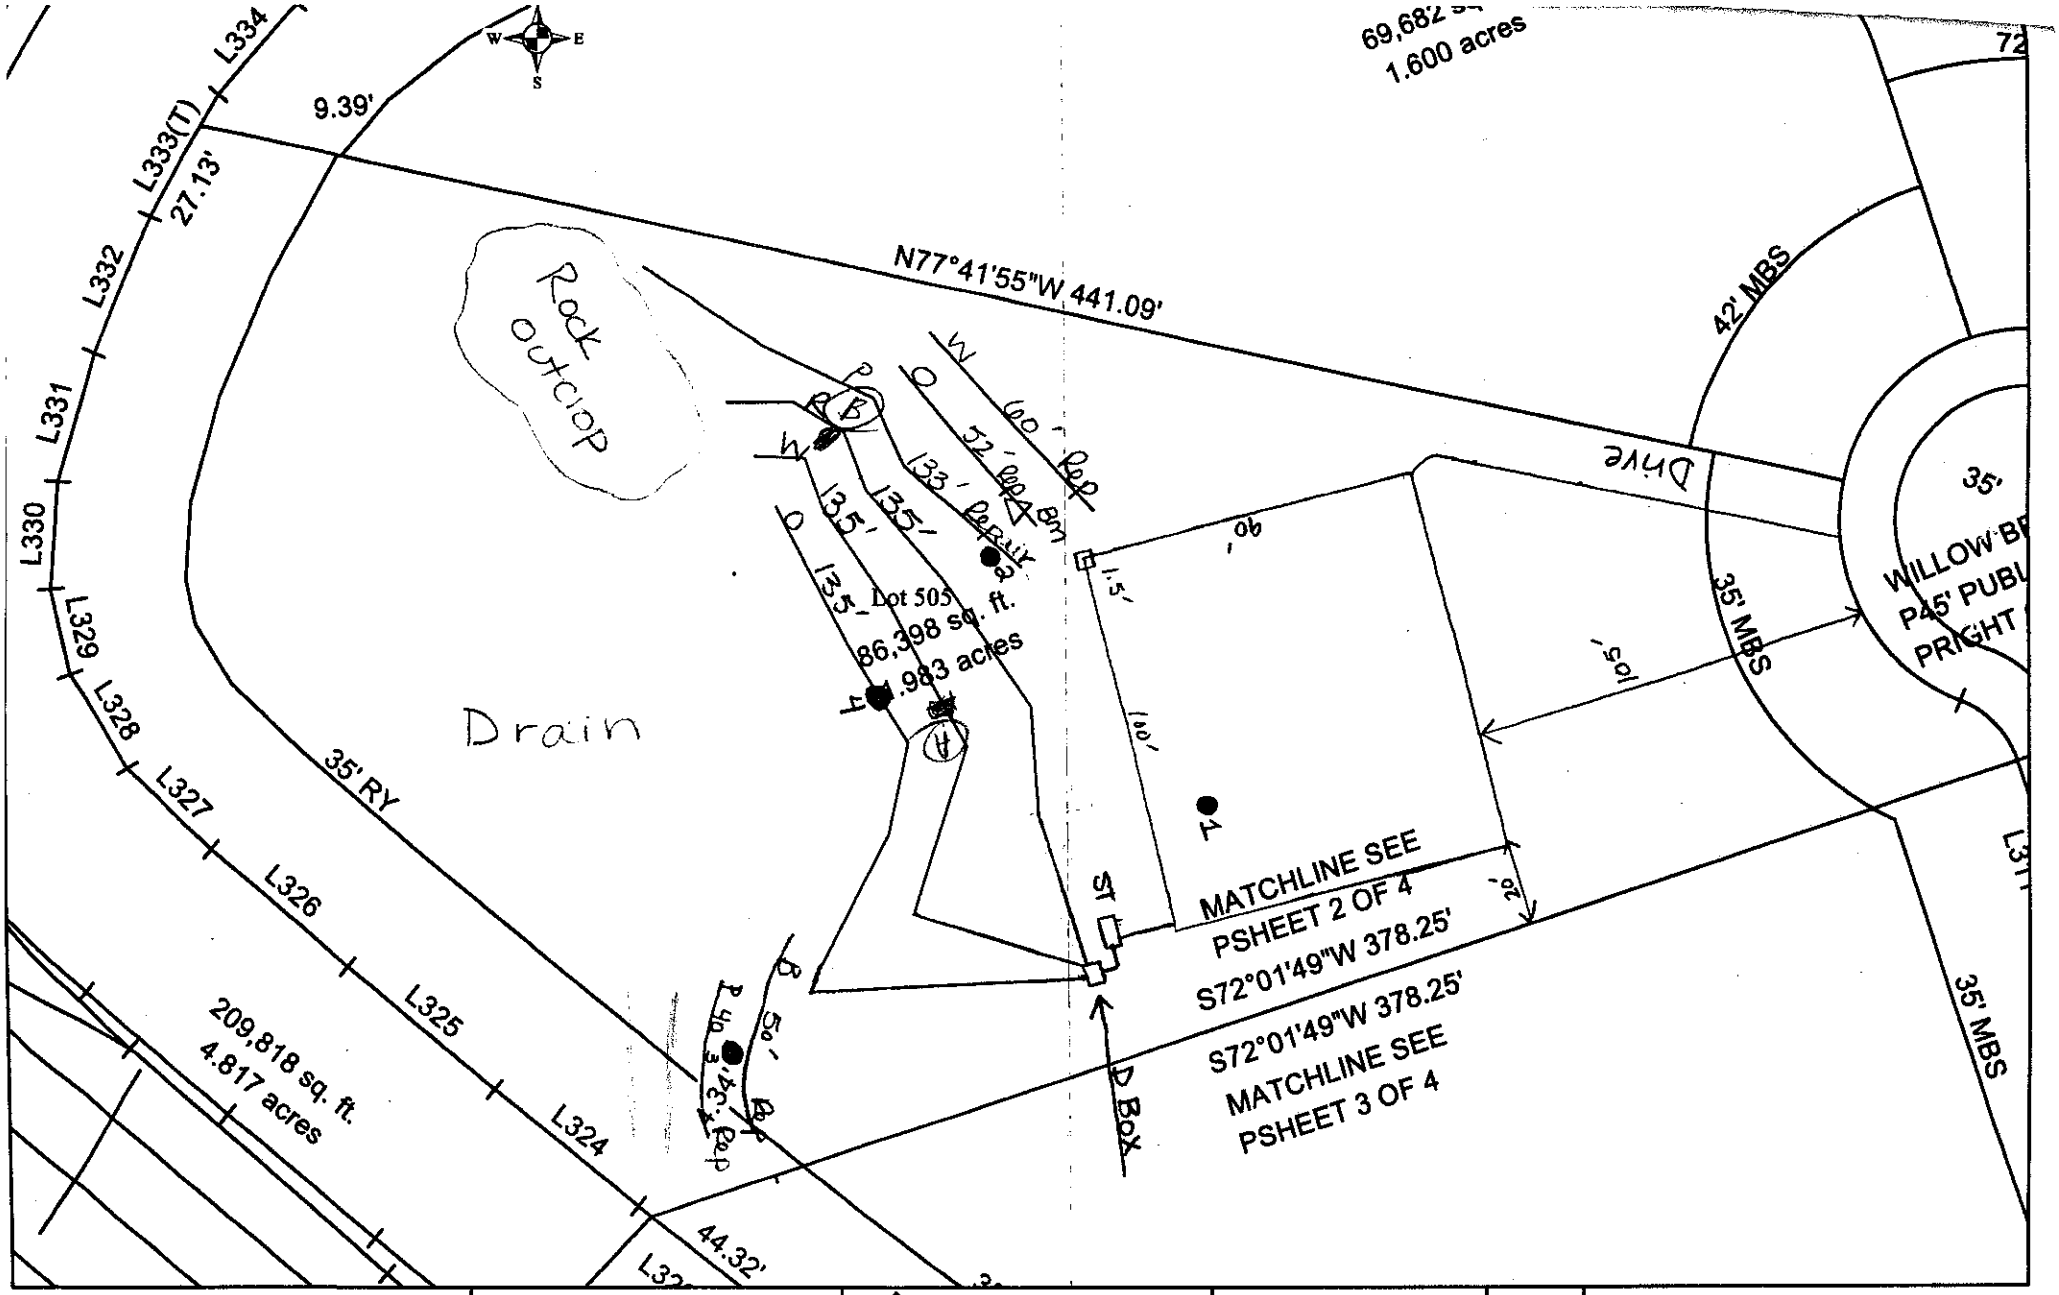

Scale: 1 inch equals 50 feet	S&ME	The Farms Phase 4	FIGURE
Drawn by: JBP		Lot 505	1
Reviewed by: PGP		Iredell County, NC	
Date: September, 2005	ENVIRONMENTAL SERVICES • ENGINEERING • TESTING	S&ME Project #1588-05--070	