IREDELL COUNTY HEALTH DEPARTMENT

STATESVILLE 704-878-5305 MOORESVILLE 704-664-5281

IMPROVEMENT PERMIT / AUTHORIZATION TO CONSTRUCT / OPERATION PERMIT / EXISTING SYSTEM INSPECTION

PERMIT# 131 332 PIN# 4626071828.506 4627107254 DATE 4-13-06

OWNER OR APPLICANT Jasper Builders PHONE: Business 799-9982 Home

ADDRESS 804 N. Main St. Mooresville, NC 28115

LOCATION Brawley School Rd TR Mckendree TR Lakeview Shores Loop TL Abbot TR Willow Bend Ct at end

SUBDIVISION The Farms BLOCK / SECTION 4 LOT 506 LOT AREA 1.60 Acre SITE CLASS. PS DESIGN FLOW 480gpd L.T.A.R. .3

Septic Tank: 1500 Gallons; STB 338 Date 8/14/06

Pump Tank: Gallons; PT Date

Pump Make: Model Serial No.

Nitrification Field: No Fields 1 Square Feet 1500' Linear Feet 500'

No Lines 4@125' Trench Width 36" Max Trench Bottom Depth 36" Gravel Depth N/A

☒ New System ☐ Repair ☐ Expansion System Type: I ☐ II ☐ III ☐ IV ☐ V ☐ VI

System Description: Gravity 25% Red Accepted

Repair System Description: LP/PBPS

Maintenance Agreement Required: ☐ Yes ☒ No Not Initially

☒ House/Mod. Home ☐ Mobile Home ☐ Business ☐ Other

No. Bedrooms 4 No. Persons No. Employees

Water Supply: ☐ Individual ☒ Public ☒ Community


☒ Gravity ☐ Pressure ☐ Slab ☒ Crawl Space ☐ Basement w/plumbing ☐ Basement wo/plumbing

Comments:/Conditions: Keep Septic System at least 10' from PL & 10' from house. Stay 15ft or more from Cut 2ft or greater.


Comments:/Conditions:

Scale 1:50

INITIAL SITE SKETCH

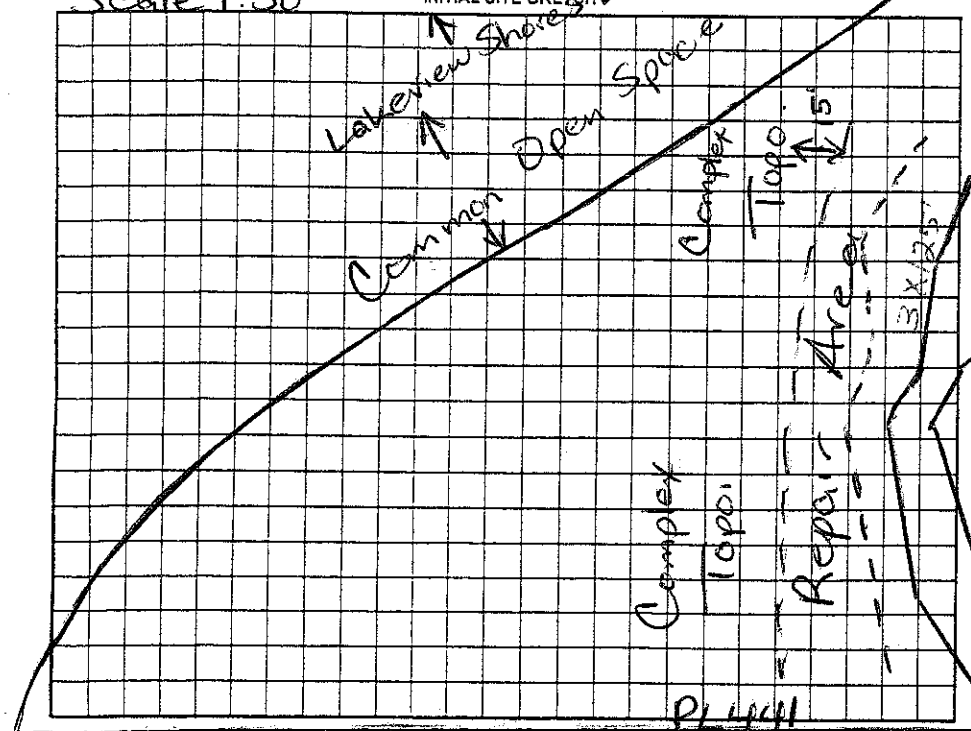

AS BUILT SKETCH

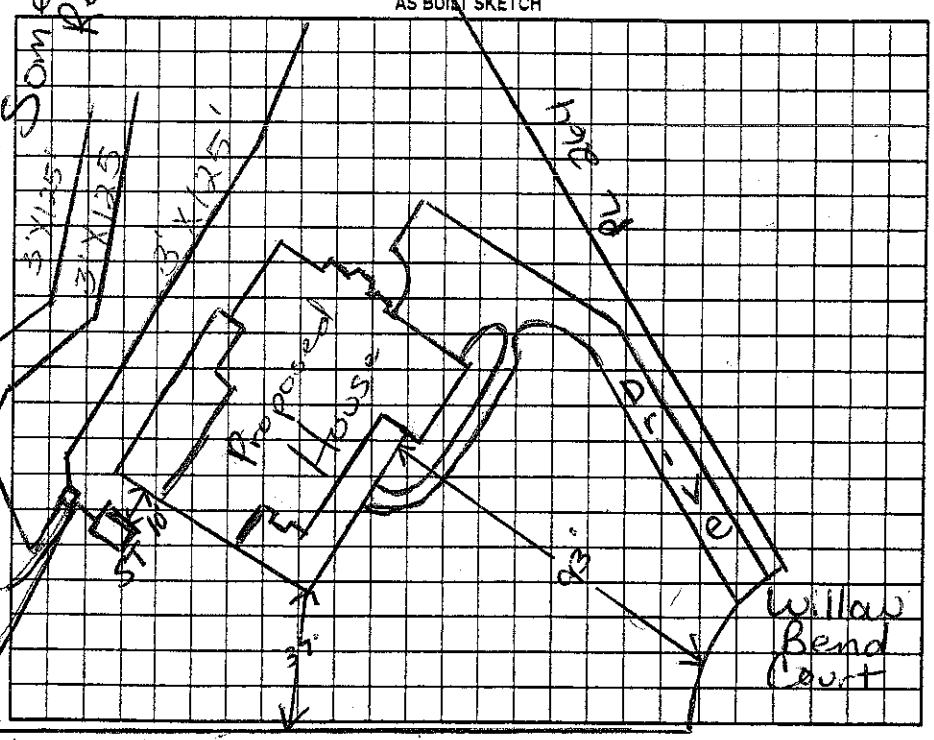

Permit can be suspended or revoked if any false information is supplied toward securing the permit/any unauthorized changes are made to the site/any unauthorized changes are made in the installation of the system. Improvement Permit with plat valid without expiration. ☐ Improvement Permit with site plan valid for sixty months ☐ Authorization to Construct is valid for a period equal to that of Improvement Permit – not to exceed sixty months.

Signed: Terri Crawley date 4-13-06 Installed by: Abernathy

Improvement Permit by: Maina Hill Dotson RS date 4/13/06 Operation Permit by: RS date 9/26/06

Authorization to Construct by: Maina Hill Dotson RS date 4/13/06 Existing System Inspection by: date

HEALTH DEPT. COPY: WHITE OWNER COPY (FINAL): YELLOW OWNER COPY (INITIAL): PINK