Lot 1616 Sec. 8 386 Lakeview Shores

IREDELL COUNTY HEALTH DEPARTMENT

STATESVILLE 704-878-5305 MOORESVILLE 704-664-5281

IMPROVEMENT PERMIT / AUTHORIZATION TO CONSTRUCT / OPERATION PERMIT / EXISTING SYSTEM INSPECTI

PERMIT# 075407 PIN# 4627 11 3269 DATE August 25, 98

OWNER OR CONTRACTOR Christopher A. Bynum PHONE: Business Home

ADDRESS 386 Lakeview Shores Loop Mooresville

LOCATION 386 Lakeview Shores Loop McKendree Rd TR Lakeview Shores Loop - straight 1st on Abbot - Right on Lakeview Shores 1/2 mile on left

SUBDIVISION Crescent BLOCK / SECTION 8 LOT 350 LOT AREA 1.29 Ac. SITE CLASS. 45 DESIGN FLOW 480 gpd L.T.A.R. .03

Septic Tank: 1000 Gallons; STB 794 Date 2/22/99
Pump Tank: 1000 Gallons; PT 27 Date 3/29/99
Pump Make: Model Serial No.
Nitrification Field: No Fields 1 Square Feet 1200 Linear Feet 400
No Lines 3@34' Trench Width 36" Max Trench Bottom Depth 36" Gravel Depth NA

☑ New System ☐ Repair System Type: I, II, III, IV, V, VI
System Description: Pumped pm - 25% Reduction
Repair System Description: Same
Maintenance Agreement Required: ☐ Yes ☑ No


☑ House/Mod. Home No. Bedrooms 4
☐ Mobile Home No. Bathrooms 4
☐ Business No. Employees
☐ Other
☐ Slab ☐ Crawl Space ☑ Basement w/plumbing ☐ Basement wo/plumbing

Water Supply: ☑ Individual EX. ☐ Public ☐ Community


Comments:/Conditions: 760 Lake Norman * ONE INSPECTION PORT PER LATERAL

Comments:/Conditions:

INITIAL SITE SKETCH 1" = 50'

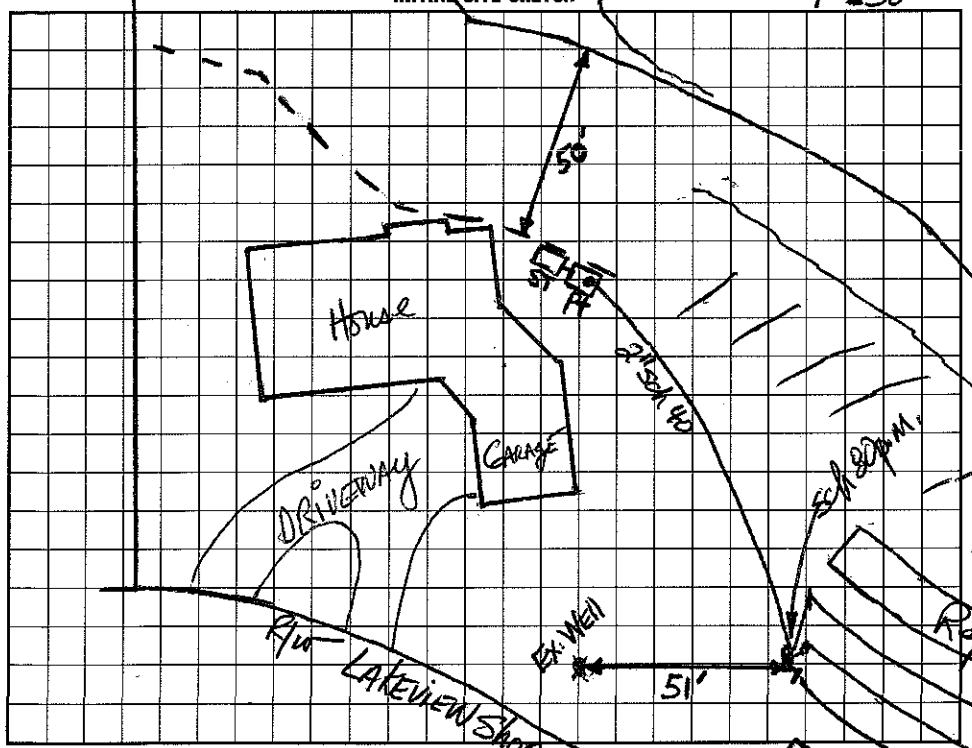

AS BUILT SKETCH

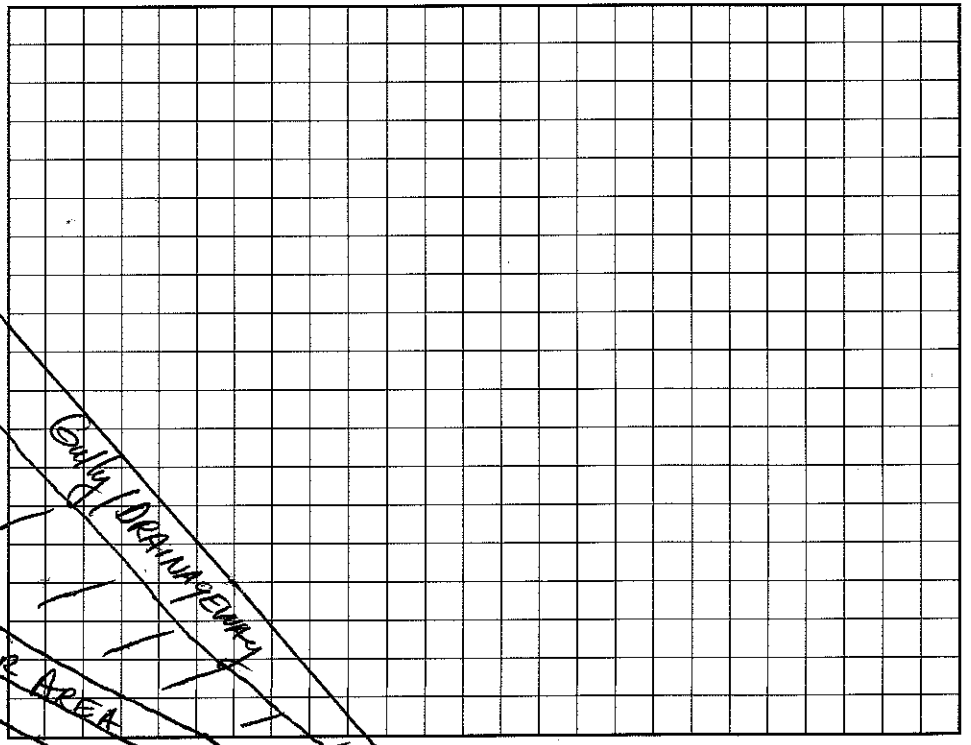

I understand that this permit can be suspended or revoked if any false information is supplied toward securing the permit/any unauthorized changes are made to the site/any unauthorized changes are made in the installation of the system. Improvement Permit with plat valid without expiration. Improvement Permit with site plan valid for sixty months. Authorization to Construct is valid for a period equal to that of Improvement Permit – not to exceed sixty months.

Signed: Christopher A Bynum 8/28/98 date Installed by: Tim Cymmons

Improvement Permit by: Renee B. Hinson, RS date 8-25-98 Operation Permit by: Wesley Sparkman date 9/9/99

Authorization to Construct by: Renee B. Hinson, RS date 8-26-98 Existing System Inspection by: date

HEALTH DEPT. COPY: WHITE INSPECTION COPY (FINAL): GREEN OWNER COPY (FINAL): YELLOW INSPECTION COPY (INITIAL): PINK OWNER COPY (INITIAL): GOLD