IREDELL COUNTY HEALTH DEPARTMENT

Authorization to Construct

2:00

STATESVILLE 704-878-5305 MOORESVILLE 704-664-5281

IMPROVEMENT PERMIT / ~~CERTIFICATE OF COMPLETION~~ / OPERATION PERMIT / EXISTING SYSTEM INSPECTION

PROPERTY DESCRIPTION NO. 24299 DATE 7/10/96 TAX MAP NO. 2L-3-4-300 Watershed: ☑ Yes ☐ No

OWNER OR CONTRACTOR Richard Evesen PHONE: Business _____ Home 7627115846

ADDRESS 607 Bluefield Rd Mooresville NC

LOCATION Brawley School Rd - TR Melandree - TR Lake View Shores, past Conway Ln

SUBDIVISION CLOT BLOCK / SECTION 8 LOT 300 LOT AREA – SITE CLASS. PS DESIGN FLOW 360 L.T.A.R. .3 gpd/ft²

Septic Tank: 1000 Gallons; STB 794 Date 9/5/97

Pump Tank: _____ Gallons; PT _____ Date _____

Pump Make: _____ Model _____ Serial No. _____

Nitrification Field: No Fields 1 Square Feet 600 Linear Feet 200

No Lines 4 Trench Width 36" Max Trench Bottom Depth 36" Gravel Depth N/A

☑ New System ☐ Repair System Type: I, II, III, IV, V, VI

System Description: Gravity Fed

Repair System Description: Dated before 83

Maintenance Agreement Required: ☐ Yes ☑ No

☑ House/Mod. Home No. Bedrooms 3

☐ Mobile Home No. Bathrooms 2

☐ Business No. Employees ____

☐ Other _____


☐ Slab ☐ Crawl Space ☑ Basement w/plumbing ☐ Basement wo/plumbing

Water Supply: ☑ Individual ☐ Community ☐ Public


Comments:

Comments:

INITIAL SITE SKETCH Not To Scale

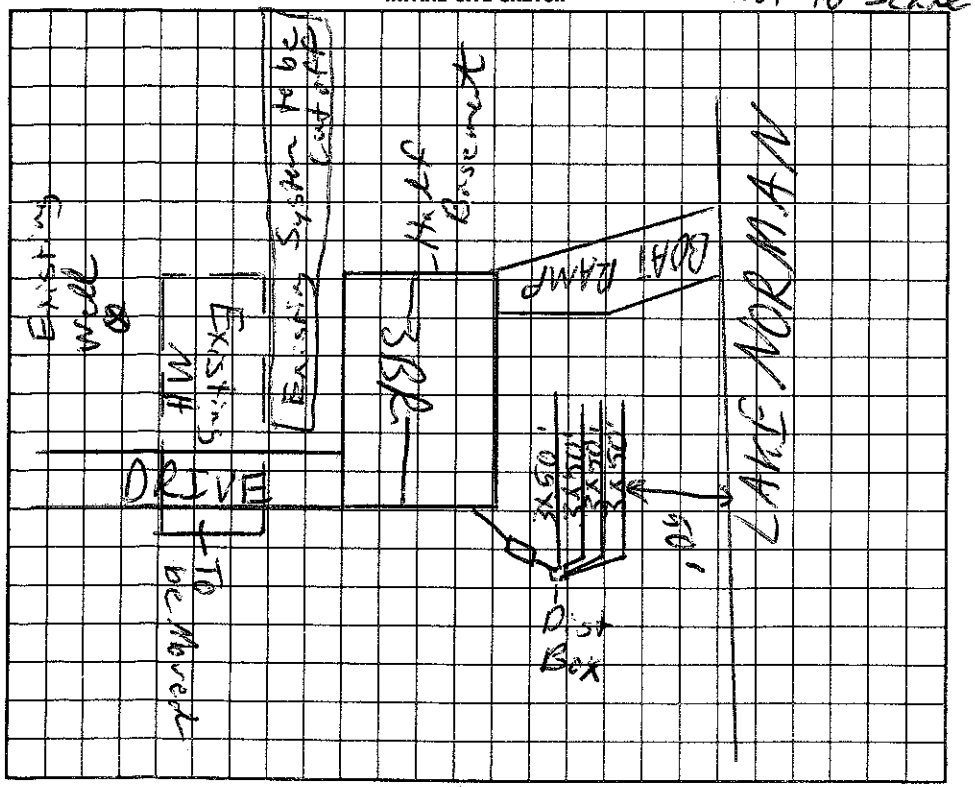

AS BUILT SKETCH

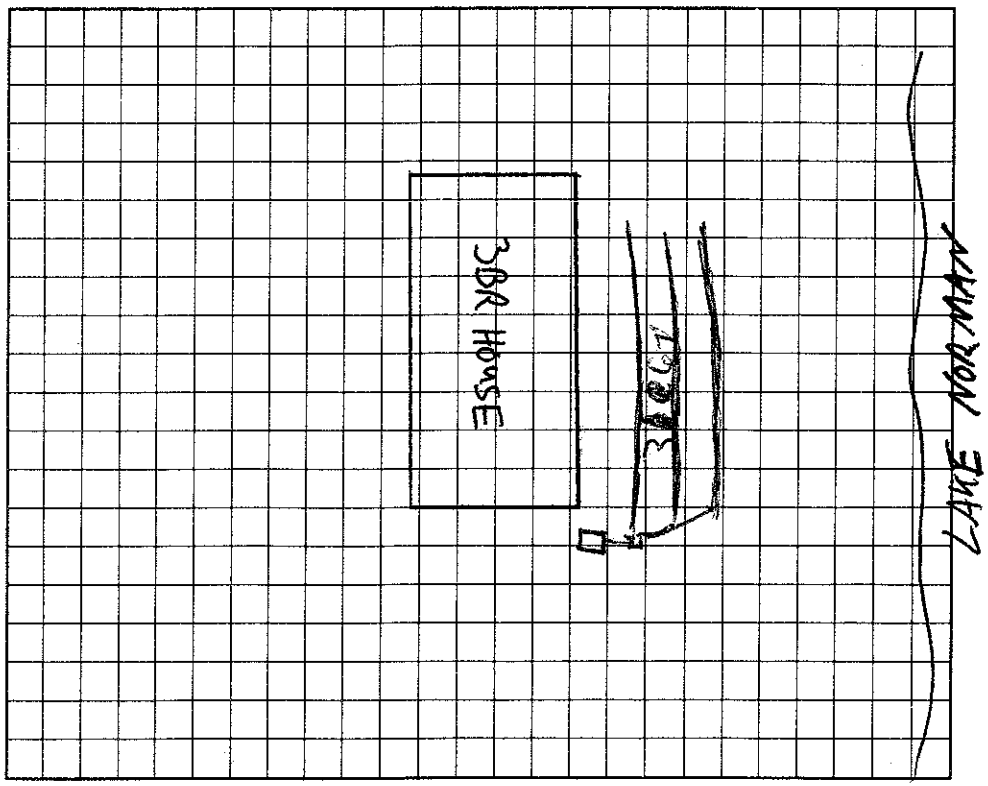

I understand that this permit can be suspended or revoked if any false information is supplied toward securing the permit/any unauthorized changes are made to the site/any unauthorized changes are made in the installation of the system.

Signed: _____

Installed by: FJ ERVEN

Improvement Permit by: C. Ruby Thomas EHS date 7/10/96

Construction Authorization ~~Existing System Inspection~~ by: C. Ruby Thomas EHS date 7/10/96

Certificate of Completion by: _____ date _____

Operation Permit by: C. Ruby Thomas date 11/14/97

HEALTH DEPT. COPY: WHITE INSPECTION COPY (FINAL): GREEN OWNER COPY (FINAL): YELLOW INSPECTION COPY (INITIAL): PINK OWNER COPY (INITIAL): GOLD

Authorization to Construct is valid for 60 months from issue date.