IREDELL COUNTY HEALTH DEPARTMENT

Statesville Office (704) 878-5305 Mooresville Office (704) 660-3625 PERMIT # 209790

IMPROVEMENT PERMIT / AUTHORIZATION TO CONSTRUCT / OPERATION PERMIT / EXISTING SYSTEM

PIN # 4627117067

APPLICANT: Elaine Ryan APPLICANT ADDRESS: 131 Colvard Farms Ln Mooresville, NC 28117

SITE ADDRESS: 131 Colvard Farms Ln Mooresville, NC PHONE: 704706-7424 ALT. PHONE:

SITE DIRECTIONS: Brawley School Rd

SUBDIVISION: The Farms SECTION: 4 LOT # 516 LOT AREA: 1.28 Ac DESIGN FLOW: 480gpd L.T.A.R.: .25


Exist

Septic Tank	1500 (gal)	STB	Date	☐ New System ☐ Repair ☐ Expansion	System Type: I II (III) IV V VI	☒ Residence	No. Bedrooms 4
Pump Tank	1000 (gal)	PT	Date	System Description: Pump-PM -25% Reduction LPPPBPS		☐ Business	No. Persons 8
Pump Make		Model	Serial #	Repair System Description:		☐ Other	No. Employees
# Nitrification Fields	1	# Lines	Linear Ft: 480ft	Maintenance Agreement Required:	☐ YES ☒ NO	☐ Slab	☐ Crawl Space
Trench Width		Max. Trench Bottom Depth	Gravel Depth		☐ GRAVITY ☒ PRESSURE	☒ Basement w/plumbing	☐ Basement w/o plumbing


Water Supply: ☐ Private ☐ Public ☒ Community

Comments / Conditions: The proposed "Pool house" addition does not appear to impact the existing Septic System & meets setbacks. to ( ) Septic.

INITIAL SITE SKETCH

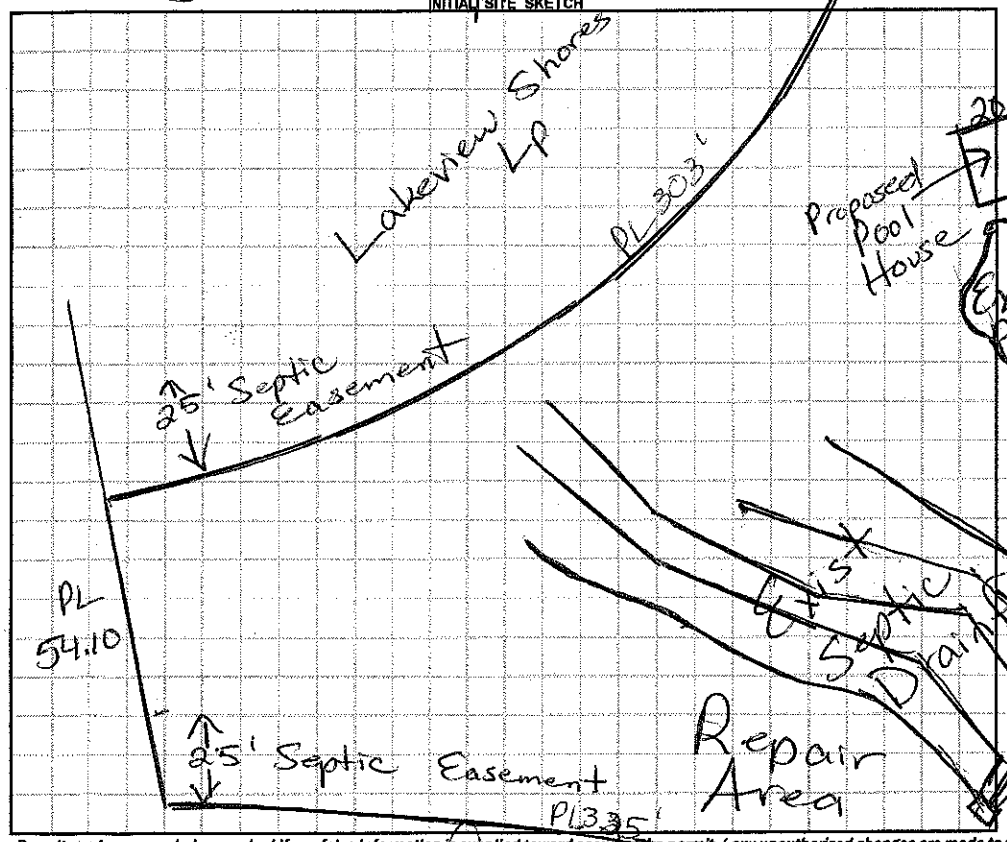

AS-BUILT SKETCH

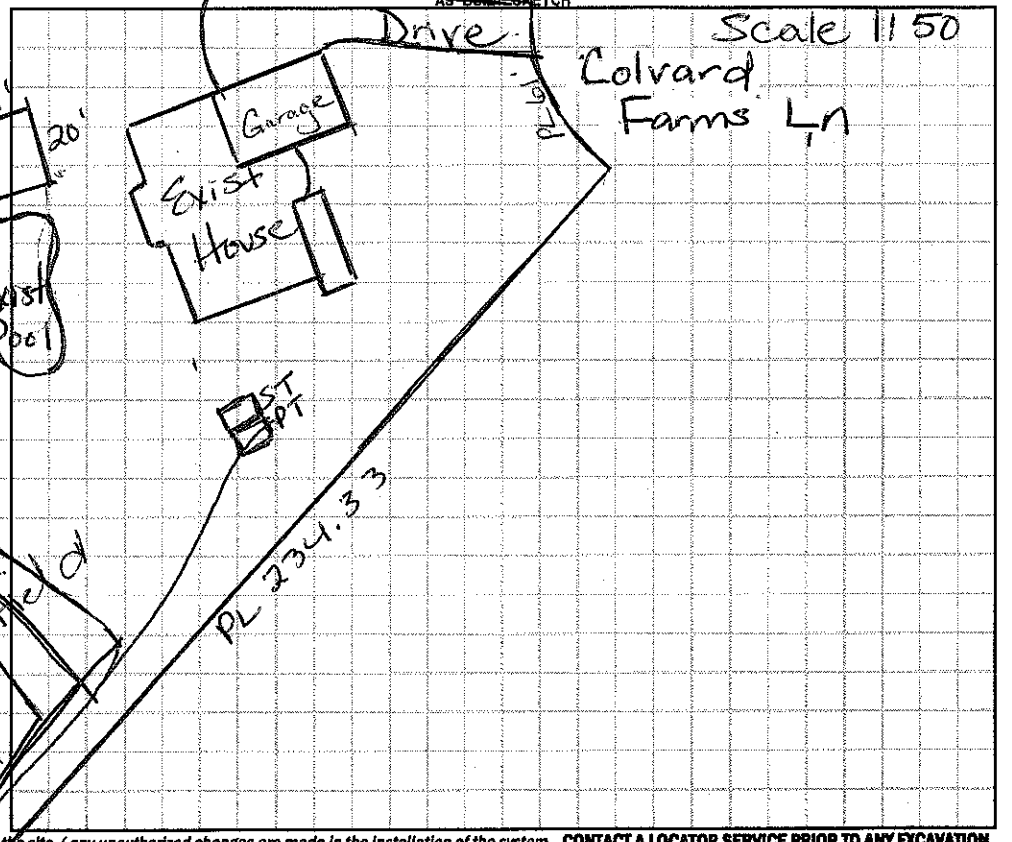

Permit can be suspended or revoked if any false information is supplied toward securing the permit / any unauthorized changes are made to the site / any unauthorized changes are made in the installation of the system. **CONTACT A LOCATOR SERVICE PRIOR TO ANY EXCAVATION**

☐ **IMPROVEMENT PERMIT** *with plat valid without expiration.* ☐ **IMPROVEMENT PERMIT** *with site plan valid for 60 mos.* ☐ **AUTHORIZATION TO CONSTRUCT** *valid for period equal to IMPROVEMENT PERMIT--not to exceed 60 mo.*

Owner / Applicant Signature: Date: 6-1-15 Installed by:

IMPROVEMENT PERMIT by: Date: OPERATION PERMIT by: Date:

AUTHORIZATION TO CONSTRUCT by: Date: Existing System Inspected by: RS Date: 6/3/15

Health Dept. Copy - WHITE Applicant (Final Approval) - YELLOW Applicant (Conditional Approval) - PINK