302C S-8. CL4T

IREDELL COUNTY HEALTH DEPARTMENT

STATESVILLE 704-878-5305 MOORESVILLE 704-664-5281

IMPROVEMENT PERMIT / AUTHORIZATION TO CONSTRUCT / OPERATION PERMIT / EXISTING SYSTEM INSPECTION

PERMIT# 97244 PIN# 4627 11 8906 DATE 4/23/98

OWNER OR CONTRACTOR Ronald Borden PHONE: Business Home 375-5536

ADDRESS 3000 Forest Lawn Dr. Matthews NC. 28105

LOCATION McKendree Rd, TR Lake View Shore Loop, straight on (R) just past Cemetery.

SUBDIVISION CL+T BLOCK / SECTION 8 LOT ~~7614~~ LOT AREA .59Ac SITE CLASS. PS DESIGN FLOW 360 L.T.A.R. 3

Septic Tank: 1000 Gallons; STB Date 302C

Pump Tank: 1000 Gallons; PT 17 Date 7/~~1990~~

Pump Make: MYERS Model ME-40 Serial No.

Nitrification Field: No Fields 1 Square Feet 750* Linear Feet *250

No Lines 5 Trench Width 36" Max Trench Bottom Depth 30" Gravel Depth SAND.

☒ New System ☐ Repair System Type: I, II, III, IV, V, VI

System Description: Trad Man — 16" APBS

Repair System Description: SAME / EASEMENT

Maintenance Agreement Required: ☐ Yes ☒ No

☒ House/Mod. Home No. Bedrooms 4

☐ Mobile Home No. Bathrooms 3

☐ Business No. Employees

☐ Other

☐ Slab ☒ Crawl Space ☐ Basement w/plumbing ☐ Basement wo/plumbing


Water Supply: ☒ Individual ☐ Public ☐ Community

Comments:/Conditions: Repair in .23 Ac Easement area across Lakeview Dr.


194

Comments:/Conditions:

INITIAL SITE SKETCH

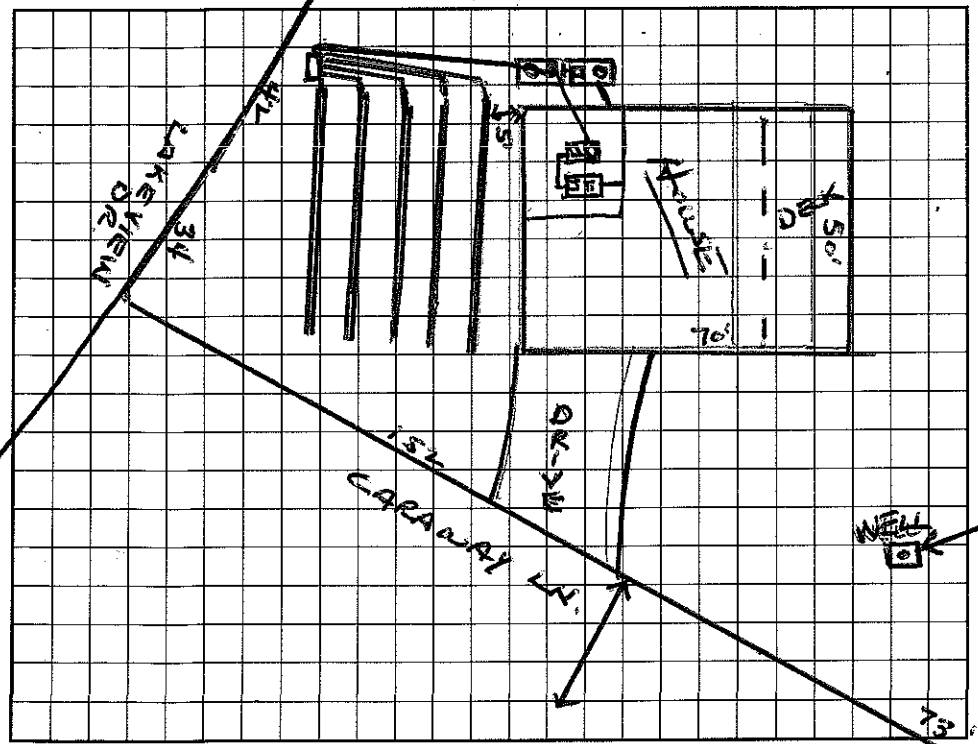

AS BUILT SKETCH

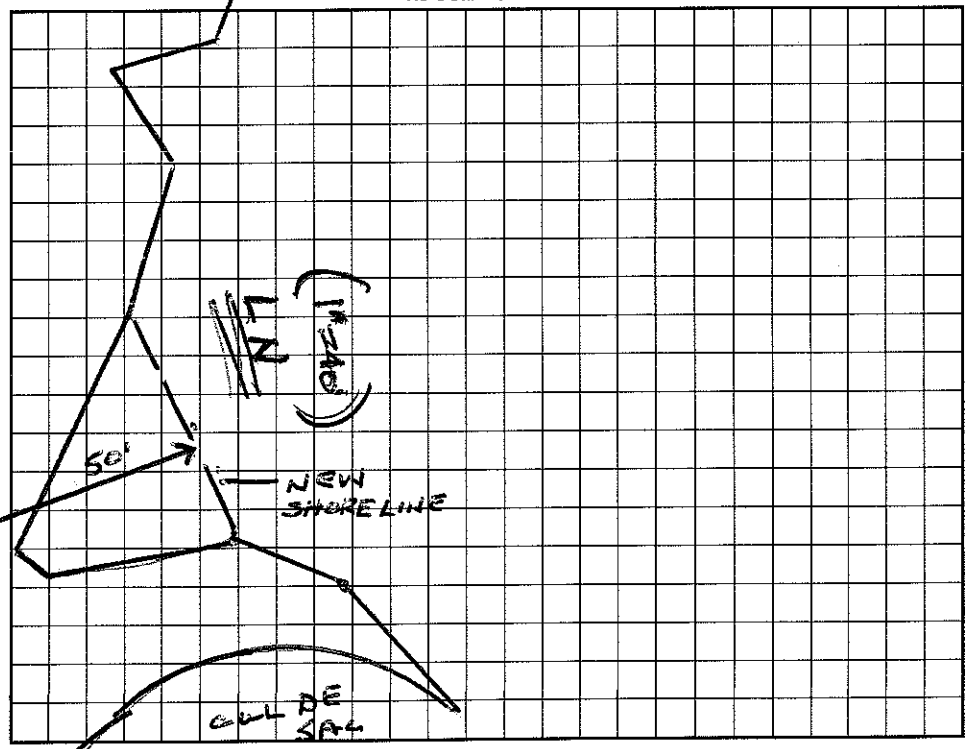

I understand that this permit can be suspended or revoked if any false information is supplied toward securing the permit/any unauthorized changes are made to the site/any unauthorized changes are made in the installation of the system. Improvement Permit with plat valid without expiration. Improvement Permit with site plan valid for sixty months. Authorization to Construct is valid for a period equal to that of Improvement Permit – not to exceed sixty months.

Signed: * date 4-23-98 Installed by: Richard Abernathy

Improvement Permit by: Wesley Sparks RS. date 4/23/98 Operation Permit by: Wesley Sparks RS. date 4/22/99

Authorization to Construct by: Wesley Sparks RS. date 4/23/98 Existing System Inspection by: date

HEALTH DEPT. COPY: WHITE INSPECTION COPY (FINAL): GREEN OWNER COPY (FINAL): YELLOW INSPECTION COPY (INITIAL): PINK OWNER COPY (INITIAL): GOLD