IREDELL COUNTY HEALTH DEPARTMENT

Statesville Phone TR 3-7271 Mooresville Phone NO 3-1271

PERMIT TO INSTALL SEPTIC TANK

Permit NO. _____ Permit Date 28 June 1965

Owner Norman Brinkley Address Kannapolis, N.C.

Installed By Sam Perkins Address Kannapolis N.C.


Location of Property Lot 306 Sec 2 Lake Norman

Tank		Capacity		Length of Lines		Fixtures	
Block	( )	800	( )	150'	( )	No. of Baths	( )
Precast	(✓)	900	( )	175'	( )	Dishwasher	( )
		1000	(✓)	200'	( )	Garbage Grdr.	( )
		1100	( )	225'	(✓)	Auto-Washer	( )
		1200	( )	250'	( )	Other	
		Other		Other			

NOTIFY HEALTH DEPARTMENT AT LEAST EIGHT HOURS BEFORE TANK IS TO BE INSPECTED.

Final Inspection 28 June 1965 Approved (✓) Disapproved ( )

Remarks _____

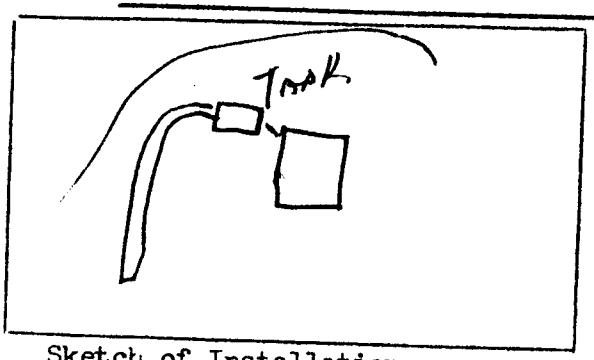

Sketch of Installation

Troy Swaggins RS
Sanitarian