IREDELL COUNTY HEALTH DEPARTMENT

STATESVILLE 704-878-5305 MOORESVILLE 704-664-5281

IMPROVEMENT PERMIT / AUTHORIZATION TO CONSTRUCT / OPERATION PERMIT / EXISTING SYSTEM INSPECTION

PERMIT# 131438 PIN# 4626 07 1828.509 4627-20-1012 DATE 6/13/06

OWNER OR APPLICANT Jasper Builders PHONE: Business 704-799-9982 Home

ADDRESS 804 N Main St. Mooresville, NC. 28115

LOCATION 1100 TR McKendree Rd. TR 1st Lakeview Shores Lp. Lon Abbott Lane TR Willow Bend Ct., 2nd on (R)

SUBDIVISION FARMS BLOCK / SECTION 4 LOT 509 LOT AREA .757 +.079 SITE CLASS. PS DESIGN FLOW 600 L.T.A.R. .3

Septic Tank: 1500 Gallons; STB 383 Date 10-17-06

Pump Tank: 1500 Gallons; PT 477 Date 11-15-06

Pump Make: Model Serial No.

Nitrification Field: No Fields 1 Square Feet 666 Linear Feet 333

No Lines 4@83 Trench Width 2-3' Max Trench Bottom Depth 3' Gravel Depth No

[X] New System [ ] Repair [ ] Expansion System Type: I II III (IV) V VI

System Description: LPP - PPBPS

Repair System Description: SAME

Maintenance Agreement Required: [X] Yes [ ] No

[X] House/Mod. Home [ ] Mobile Home [ ] Business [ ] Other

No. Bedrooms 5 No. Persons 4 No. Employees

Water Supply: [ ] Individual [ ] Public [X] Community


[ ] Gravity [X] Pressure [ ] Slab [X] Crawl Space [ ] Basement w/plumbing [ ] Basement wo/plumbing

Comments:/Conditions: NO ROOM FOR ANYTHING ELSE IN BACKYARD. VERY TIGHT.


Comments:/Conditions:

1" = 50'

INITIAL SITE SKETCH

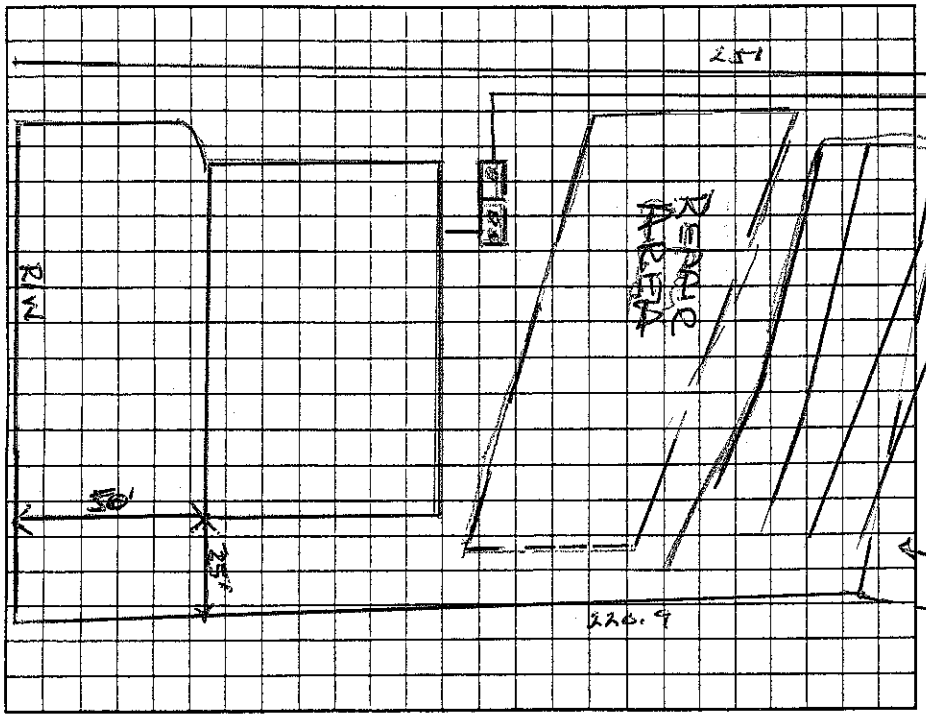

AS BUILT SKETCH

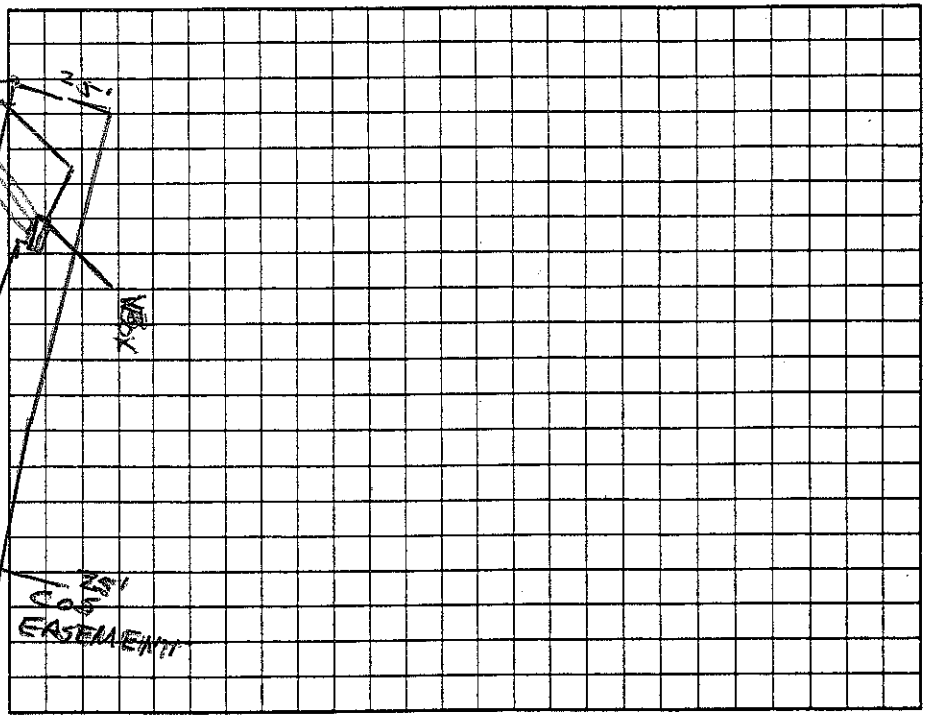

WILLOW BEND CT.

Permit can be suspended or revoked if any false information is supplied toward securing the permit/any unauthorized changes are made to the site/any unauthorized changes are made in the installation of the system. Improvement Permit with plat valid without expiration ☐ Improvement Permit with site plan valid for sixty months ☐ Authorization to Construct is valid for a period equal to that of Improvement Permit – not to exceed sixty months.

Signed: * Terri Cranley date 6/27/06

Improvement Permit by: Wesley Sparks RS. date 6/13/06

Authorization to Construct by: Wesley Sparks RS date 6/13/06

Installed by: R. Abernathy

Operation Permit by: Joph E. Alph date 1-24-07

Existing System Inspection by: date

HEALTH DEPT. COPY: WHITE OWNER COPY (FINAL): YELLOW OWNER COPY (INITIAL): PINK