IREDELL COUNTY HEALTH DEPARTMENT

Statesville Office (704) ~~878-5305~~ Mooresville Office (704) 660-3625 PERMIT # 208250

IMPROVEMENT PERMIT / AUTHORIZATION TO CONSTRUCT / OPERATION PERMIT / EXISTING SYSTEM

PIN # 4627204270

APPLICANT: Riley / Golsch Investments APPLICANT ADDRESS: 136 Sumter Dr Mooresville NC 28117

SITE ADDRESS: 158 Lakeview Shores Lp Mooresville NC PHONE: 7043638530 ALT. PHONE: 4405702943

SITE DIRECTIONS: Brawley School Rd TR McKendree TR Lakeview Shores Lp

SUBDIVISION: L&T SECTION: 8 LOT # 347 LOT AREA: DESIGN FLOW: 360gpd T.A.R.:

EXIST Septic Tank 1000 (gal) STB Date

Pump Tank (gal) PT Date

Pump Make Model Serial #

Nitrification Fields 1 # Lines 5 Linear Ft: 360'

EXIST Trench Width 15" Max. Trench Bottom Depth EXIST Gravel Depth 12"

☐ New System ☐ Repair ☐ Expansion System Type: ☐ I ☐ II ☐ III ☐ IV ☐ V ☐ VI

System Description: EXIST. Gravity-Conventional

Repair System Description: lot recorded prior to 1983

Maintenance Agreement Required: ☐ YES ☒ NO

☐ GRAVITY ☐ PRESSURE

☒ Residence No. Bedrooms 3

☐ Business No. Persons 6

☐ Other No. Employees

☐ Slab ☐ Crawl Space


☐ Basement w/plumbing ☒ Basement w/o plumbing

Water Supply: ☒ Private ☐ Public ☐ Community

Comments / Conditions: Septic System "appears" to be functioning OKay at time of Inspection.

The proposed deck addition does not appear to impact the existing Septic System

INITIAL SITE SKETCH

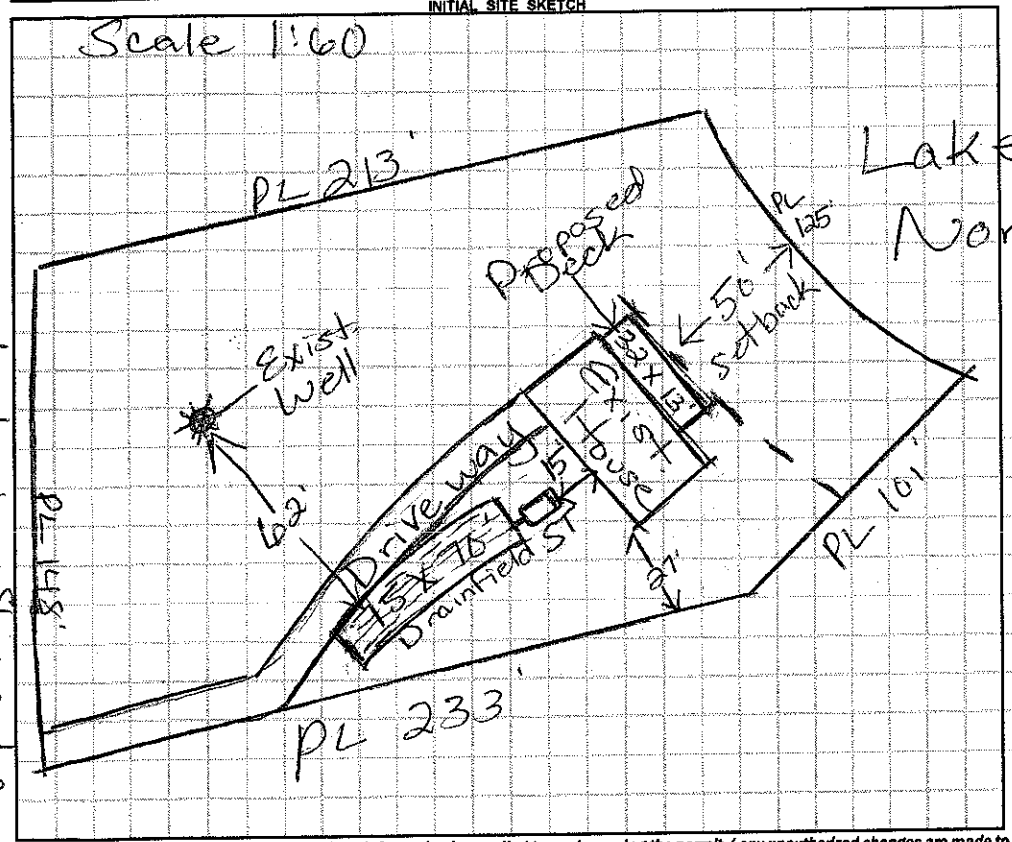

AS BUILT SKETCH

Permit can be suspended or revoked if any false information is supplied toward securing the permit / any unauthorized changes are made to the site / any unauthorized changes are made in the installation of the system. **CONTACT A LOCATOR SERVICE PRIOR TO ANY EXCAVATION**

☐ **IMPROVEMENT PERMIT** *with plat valid without expiration.* ☐ **IMPROVEMENT PERMIT** *with site plan valid for 60 mos.* ☐ **AUTHORIZATION TO CONSTRUCT** *valid for period equal to IMPROVEMENT PERMIT--not to exceed 60 mo.*

Owner / Applicant Signature: Date: 3/13/15 Installed by:

IMPROVEMENT PERMIT by: Date: OPERATION PERMIT by: Date:

AUTHORIZATION TO CONSTRUCT by: Date: Existing System Inspected by: Date: 3/13/15

Health Dept. Copy - WHITE Applicant (Final Approval) - YELLOW Applicant (Conditional Approval) - PINK