# IREDELL COUNTY HEALTH DEPARTMENT

AUTHORIZATION TO CONSTRUCT

STATESVILLE 704-878-5305 MOORESVILLE 704-664-5281

## IMPROVEMENT PERMIT / ~~CERTIFICATE OF COMPLETION~~ / OPERATION PERMIT / EXISTING SYSTEM INSPECTION

PROPERTY DESCRIPTION NO. 24112 DATE 8/14/96 TAX MAP NO. 2L-3-A-348 4627205027 Watershed: ☑ Yes ☐ No

OWNER OR CONTRACTOR D. GLENN OWEN PHONE: Business _____ Home 664-6332

ADDRESS 154 LAKEVIEW SHORES LOOP MOORESVILLE NC 28115

LOCATION BRAWLEY SCHOOL RD. - TR MCKENDREE - TR LAKEVIEW LOOP - 2ND LOT AFTER ABBOT RD ON RT.

SUBDIVISION CRESCENT RES. BLOCK / SECTION 8 LOT 348 LOT AREA _____ SITE CLASS. PS DESIGN FLOW 480 GPD L.T.A.R. 2 GPD/FT²

Septic Tank: 1000 Gallons; STB 794 Date 9/23/97

Pump Tank: 1000 Gallons; PT 27 Date 9/16/97

Pump Make: ZOELLER Model N137L Serial No. _____

Nitrification Field: No Fields 1 Square Feet 630 Linear Feet 210

No Lines 3 @ 70 Trench Width 36" Max Trench Bottom Depth 36" Gravel Depth 12"

☑ New System ☐ Repair System Type: I, II, (III) IV, V, VI

System Description: PUMP CONVENTIONAL

Repair System Description: SAME

Maintenance Agreement Required: ☐ Yes ☑ No

☑ House/Mod. Home ☐ Mobile Home ☐ Business ☐ Other

No. Bedrooms 4 No. Bathrooms 3 No. Employees ____


☐ Slab ☐ Crawl Space ☐ Basement w/plumbing ☑ Basement wo/plumbing

Water Supply: ☑ Individual ☐ Community ☐ Public

Comments:

Comments:

INITIAL SITE SKETCH

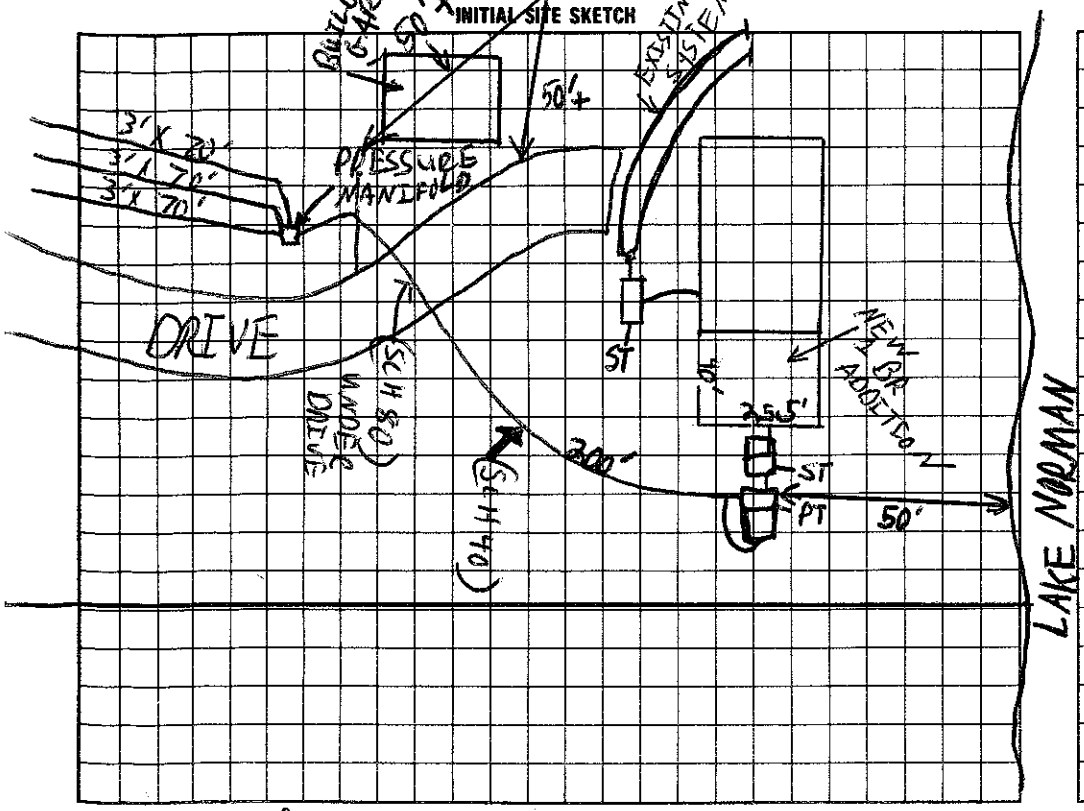


AS BUILT SKETCH

I understand that this permit can be suspended or revoked if any false information is supplied toward securing the permit/any unauthorized changes are made to the site/any unauthorized changes are made in the installation of the system.

Signed: D Glenn Owen

Installed by: Bowers

Improvement Permit by: C. Ray Freeman EHSI date 8/14/96

AUTHORIZATION Existing System Inspection by: C Ray Freeman EHSI date 8/14/96

Certificate of Completion by: _____ date _____

Operation Permit by: C. Ray Freeman date 11/19/97

HEALTH DEPT. COPY: WHITE INSPECTION COPY (FINAL): GREEN OWNER COPY (FINAL): YELLOW INSPECTION COPY (INITIAL): PINK OWNER COPY (INITIAL): GOLD

TO CONSTRUCT IS VALID FOR 60 MONTHS FROM ISSUE DATE.