IREDELL COUNTY HEALTH DEPARTMENT

STATESVILLE 704-878-5305 MOORESVILLE 704-664-5281

IMPROVEMENT PERMIT / AUTHORIZATION TO CONSTRUCT / OPERATION PERMIT / EXISTING SYSTEM INSPECTION

PERMIT# 106226 PIN# 4627206666 DATE 7/17/2002

OWNER OR CONTRACTOR Henry & Carol Stakely PHONE: Business Home 663-2568

ADDRESS 196 Lakeview Shores Lp Mooresville NC 28117

LOCATION Brawley School Rd TR McKendree TR Lakeview Shores Lp #196

SUBDIVISION C L & T J BLOCK / SECTION 8 LOT LOT AREA .74Acre SITE CLASS PS DESIGN FLOW 360gpd L.T.A.R.

Septic Tank: Existing Gallons: STB Date

Pump Tank: Gallons: PT Date

Pump Make: Model Serial No.

Nitrification Field: No Fields Square Feet Linear Feet

No Lines Trench Width Existing Max Trench Bottom Depth Gravel Depth

☐ New System ☐ Repair System Type: I, II, III, IV, V, VI

System Description: Existing Gravity-Conventional

Repair System Description:

Maintenance Agreement Required: ☐ Yes ☒ No

☒ House/Mod. Home ☐ Mobile Home ☐ Business ☐ Other

No. Bedrooms 3 No. Bathrooms 3 No. Employees


☒ Slab ☒ Crawl Space ☐ Basement w/plumbing ☐ Basement wo/plumbing

Water Supply: ☒ Individual ☒ Public ☐ Community

Comments/Conditions: Existing Septic System appears to be functioning okay at time of inspection.

Comments/Conditions: Proposed Additions do not encroach on Septic areas

INITIAL SITE SKETCH Lakeview Shores Lp

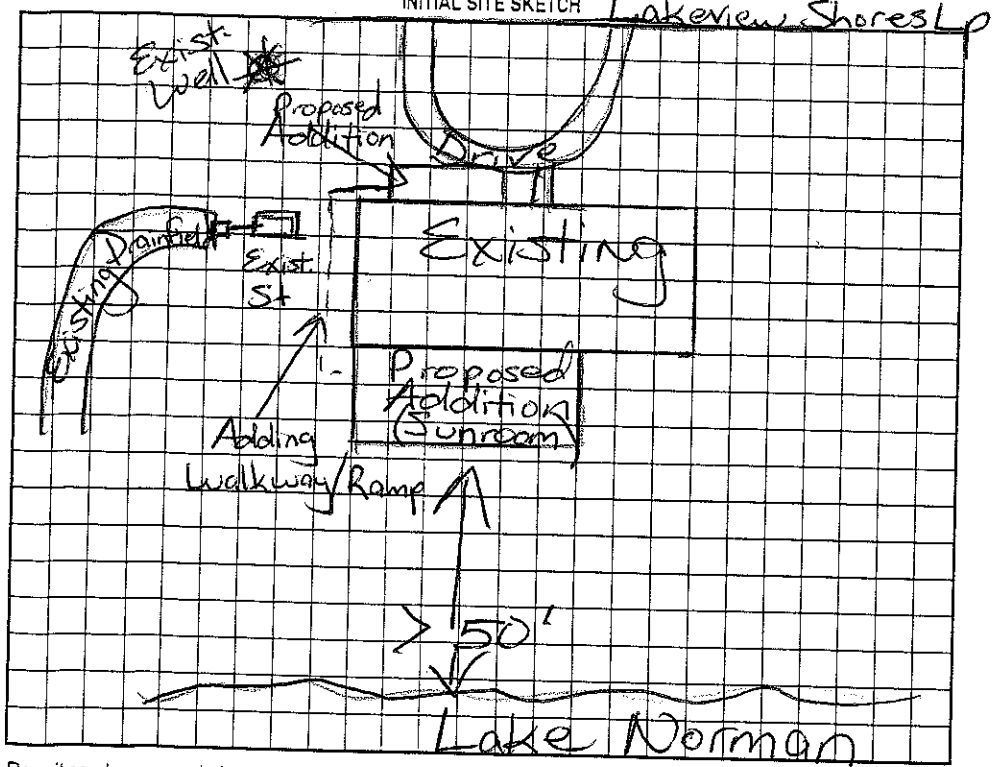

AS BUILT SKETCH

Permit can be suspended or revoked if any false information is supplied toward securing the permit/any unauthorized changes are made to the site/any unauthorized changes are made in the installation of the system. Improvement Permit with plat valid without expiration. Improvement Permit with site plan valid for sixty months. Authorization to Construct is valid for a period equal to that of Improvement Permit – not to exceed sixty months.

Signed: X

Improvement Permit by: Maina H. Dolson R.S. date 7/17/2002

Authorization to Construct by: date

Installed by:

Operation Permit by: date

Existing System Inspection by: Maina H. Dolson R.S. date 7/17/2002

HEALTH DEPT. COPY: WHITE OWNER COPY (FINAL): YELLOW OWNER COPY (INITIAL): PINK