IREDELL COUNTY HEALTH DEPARTMENT

STATESVILLE 704-878-5305 525.00 Pd MOORESVILLE 704-664-5281

IMPROVEMENT PERMIT / AUTHORIZATION TO CONSTRUCT / OPERATION PERMIT / EXISTING SYSTEM INSPECTION

PERMIT# 12144620 PIN# 4627 21 0579 DATE 7/23/05

OWNER OR CONTRACTOR James M Cromer PHONE: Business Home 704-658-0275

ADDRESS 112 Lake View Shores Lp. Mooresville, NC. 28117

LOCATION 314 Lake View Shores Lp.

SUBDIVISION CL+T BLOCK / SECTION 8 LOT 310 LOT AREA .71AC SITE CLASS PS DESIGN FLOW 480 L.T.A.R. .3

Septic Tank: 1000 Gallons; STB 794 Date 9/21/05
Pump Tank: 1000 Gallons; PT 27 Date 11/29/05
Pump Make: Model Serial No.
Nitrification Field: No Fields 1 Square Feet 798 Linear Feet 266
No Lines ~~266~~ Trench Width 3' Max Trench Bottom Depth 3'

[X] New System [ ] Repair System Type: I, II, III, IV, V, VI
System Description: LP - PPBPS 16"
Repair System Description: < 1983
Maintenance Agreement Required: [X] Yes [ ] No
Gravel Depth NA [ ] Slab [ ] Crawl Space [X] Basement w/plumbing [ ] Basement wo/plumbing


[X] House/Mod. Home No. Bedrooms 4
[ ] Mobile Home No. Bathrooms 4
[ ] Business No. Employees
[ ] Other

Water Supply: [X] Individual [ ] Public [ ] Community

Comments:/Conditions: Maintenance Contract Required Type 4 System; Driveway must not be cut down - and routed around LN Trenfield area 3/16" holes 1 per panel LN = 3' of head pressure 61 Panels. 45 GPM Minimum EH to be measured on site by Contractor

Comments:/Conditions:

INITIAL SITE SKETCH

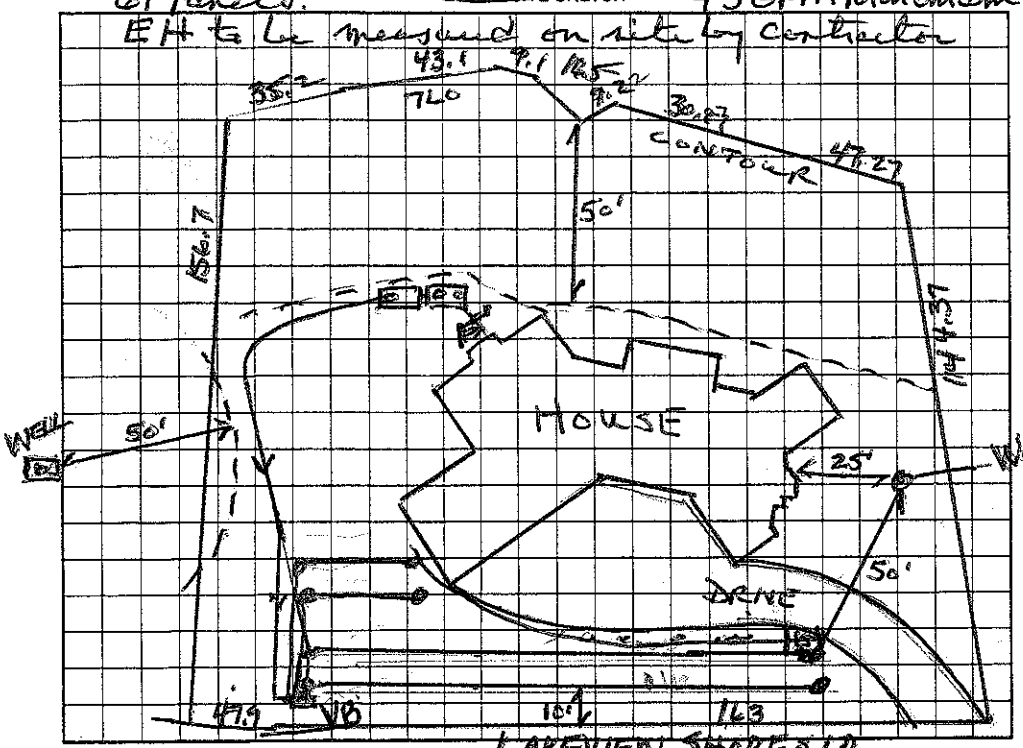

4 lines - 2@30' 2@40'

AS BUILT SKETCH

Permit can be suspended or revoked if any false information is supplied toward securing the permit/any unauthorized changes are made to the site/any unauthorized changes are made in the installation of the system. Improvement Permit with plat valid without expiration. Improvement Permit with site plan valid for sixty months. Authorization to Construct is valid for a period equal to that of Improvement Permit – not to exceed sixty months.

Signed: [signature] date 8/1/05 Installed by: Dobson + Sons

Improvement Permit by: Wesley Sparks RS. date 7/23/05 Operation Permit by: Wesley Sparks RS. date 7/31/06

Authorization to Construct by: Wesley Sparks RS date 7/23/05 Existing System Inspection by: date

HEALTH DEPT. COPY: WHITE OWNER COPY (FINAL): YELLOW OWNER COPY (INITIAL): PINK