IREDELL COUNTY HEALTH DEPARTMENT

Statesville Phone TR 3-7271 Mooresville Phone NO 3-1271

PERMIT TO INSTALL SEPTIC TANK

Permit No. 51 Permit Date June - 1 19 71

Owner Bob Bell Address MATTHEWS. NC

Installed By Dobson Address Mooresville NC

Location of Property


Section 8 - LOT 310.

Tank		Capacity		Length of Lines		Fixtures	
Block	( )	1000	( )	225'	( )	No. of Baths	( )
Precast	( )	1250	( )	250'	( )	Dishwasher	( )
		1500	( )	Other 123 Extra Stone		Garbage Grdr.	( )
		Other				Other	

NOTIFY HEALTH DEPARTMENT AT LEAST EIGHT HOURS BEFORE TANK IS TO BE INSPECTED.

Final Inspection June 1 19 71 Approved (Y) Disapproved ( )

Remarks

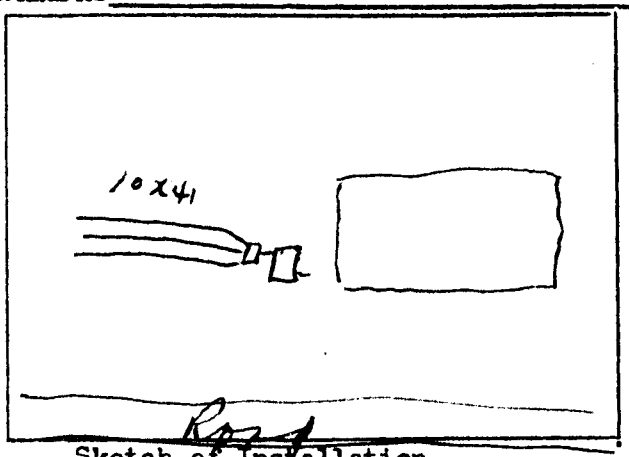

Sketch of Installation

This lot too small. and Crowded. Extra Stone in Nitrification field - Soil Good

Glenn Tabor

Sanitarian