IREDELL COUNTY HEALTH DEPARTMENT

Statesville Office (704) 878-5305 Mooresville Office (704) 660-3625 AHP PERMIT # 207559 ✓

IMPROVEMENT PERMIT / AUTHORIZATION TO CONSTRUCT / OPERATION PERMIT / EXISTING SYSTEM

PIN # 4627-21-0925

APPLICANT: ROBERT WILLIAMS APPLICANT ADDRESS: 258 SCENIC DR. CONCORD

SITE ADDRESS: 106 CARAWAY LN. PHONE: 704-788-4094 ALT. PHONE:

SITE DIRECTIONS: BSR, MCKENDREE, LAKE VIEW SHORES, CARAWAY, ON R

SUBDIVISION: CLET SECTION: 8 LOT # 308 LOT AREA: .67 AC DESIGN FLOW: 480 L.T.A.R.: .3

Septic Tank Ex. 1000 (gal) STB Date

Pump Tank (gal) PT Date

Pump Make Model Serial #

Nitrification Fields 1 # Lines 3C44 Linear Ft: 132'

Trench Width 24" Max. Trench Bottom Depth 36" Gravel Depth —

☐ New System ☐ Repair ☒ Expansion System Type: I II (III) IV V VI

System Description: GRAVEL BED & PANEL BLOCK

Repair System Description: PANEL BLOCK

Maintenance Agreement Required: ☐ YES ☒ NO

☒ GRAVITY ☐ PRESSURE

☒ Residence No. Bedrooms 4

☐ Business No. Persons

☐ Other No. Employees

☐ Slab ☒ Crawl Space


☐ Basement w/plumbing ☐ Basement w/o plumbing

Water Supply: ☒ Private ☐ Public ☐ Community


Comments / Conditions:

2 BR ADDITION

INITIAL SITE SKETCH

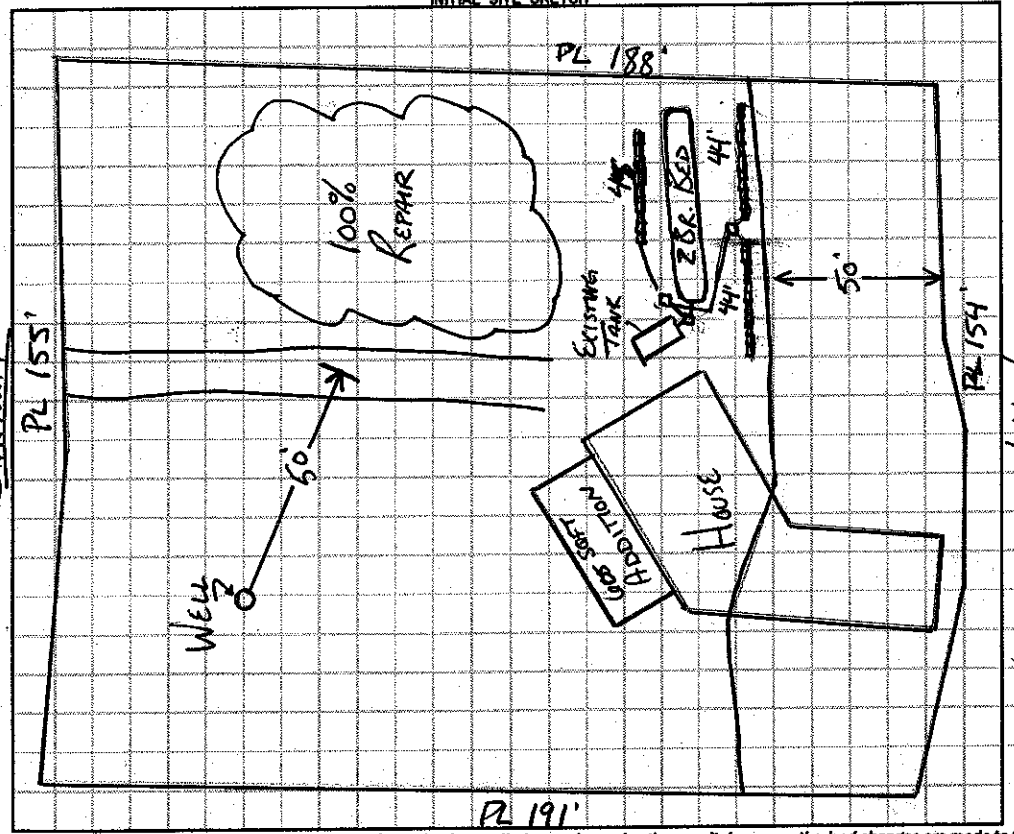

AS BUILT SKETCH

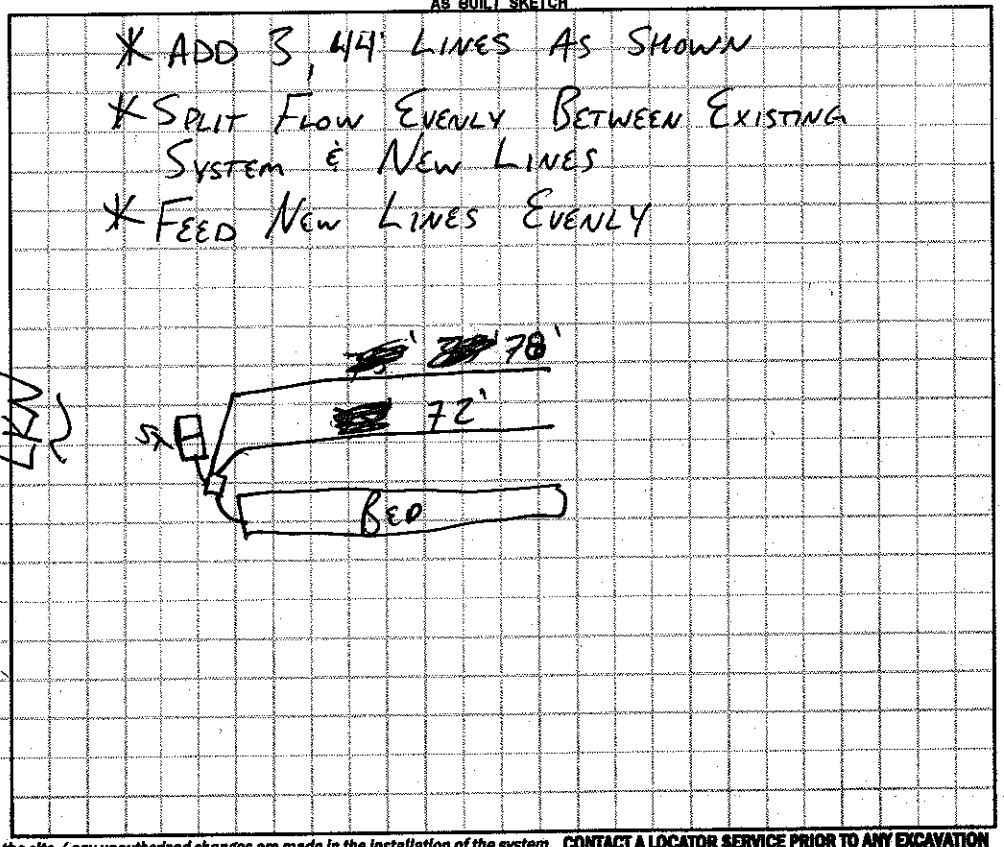

Permit can be suspended or revoked if any false information is supplied toward securing the permit / any unauthorized changes are made to the site / any unauthorized changes are made in the installation of the system. **CONTACT A LOCATOR SERVICE PRIOR TO ANY EXCAVATION**

☐ **IMPROVEMENT PERMIT** *with plat valid without expiration.* ☐ **IMPROVEMENT PERMIT** *with site plan valid for 60 mos.* ☒ **AUTHORIZATION TO CONSTRUCT** *valid for period equal to IMPROVEMENT PERMIT--not to exceed 60 mo.*

Owner / Applicant Signature: Patricia Williams Date: 1/16/15 2015 Installed by:

IMPROVEMENT PERMIT by: Date: APPROVED JAN 14 2014 OPERATION PERMIT by: Date:

AUTHORIZATION TO CONSTRUCT by: Date: APPROVED JAN 14 2014 2015 Existing System Inspected by: Date:

Health Dept. Copy - WHITE Applicant (Final Approval) - YELLOW Applicant (Conditional Approval) - PINK