IREDELL COUNTY HEALTH DEPARTMENT

Statesville Phone TR 3-7271 Mooresville Phone NO 3-1271

PERMIT TO INSTALL SEPTIC TANK

Permit No. 111 Permit Date 8-20 1971

Owner Melville Address Statesville

Installed By Adams Address Taylorsville


Location of Property Sec 8 315 + 314

| Tank | | Capacity | | Length of Lines | | Fixtures | |
|---|---|---|---|---|---|---|---|
| Block | ( ) | 1000 | ( ) | 225' | ( ) | No. of Baths | (5) |
| Precast | (✓) | 1250 | (✓) | 250' | ( ) | Dishwasher | (✓) |
| | | 1500 | ( ) | Other 270 | | Garbage Grdr. | (✓) |
| | | Other | | | | Other | |

NOTIFY HEALTH DEPARTMENT AT LEAST EIGHT HOURS BEFORE TANK IS TO BE INSPECTED.

Final Inspection 8-20-1971 Approved (✓) Disapproved ( )

Remarks

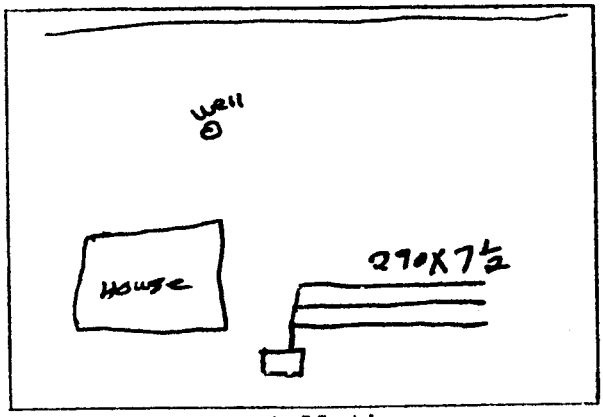


Sketch of Installation

J. C. Moore

Sanitarian