IREDELL COUNTY HEALTH DEPARTMENT

STATESVILLE 704-878-5305 MOORESVILLE 704-664-5281

IMPROVEMENT PERMIT / AUTHORIZATION TO CONSTRUCT / OPERATION PERMIT / EXISTING SYSTEM INSPECTION

375.00 9.17 10.50

PERMIT# 13458 PIN# 4626-07-1828.504 4627-21-~~8221~~ 5583 DATE Sept 29, 05

OWNER OR CONTRACTOR The Farms, LLC / John R. Poore PHONE: Business _____ Home _____

ADDRESS 2214 Brawley Sch Rd, Mooresville, N.C. 28117

LOCATION Brawley Sch Rd TR McKendree TR Lakeview Shores Loop TR Grave Creek Way TR Hammersmith Farms Ln. - at end

SUBDIVISION The Farms BLOCK / SECTION 4 LOT 524 LOT AREA ±.821 Ac SITE CLASS. B DESIGN FLOW 480gpd L.T.A.R. .25

Septic Tank: 1000 Gallons: STB 338 Date 9-19-06

Pump Tank: 1000 Gallons: PT 27 Date 9-27-06

Pump Make: Goulds Model WE0312M Serial No. _____

Nitrification Field: No Fields 1 Square Feet 640/960 Linear Feet 320

No Lines 2 (CF) Trench Width 24"min@8"oc Max Trench Bottom Depth 36" Gravel Depth NA

☒ New System ☐ Repair System Type: I, II, III, IV, V, VI

System Description: LPPBPS

Repair System Description: LPPBPS

Maintenance Agreement Required: ☒ Yes ☐ No

☒ House/Mod. Home No. Bedrooms 4

☐ Mobile Home No. Bathrooms _____

☐ Business No. Employees _____

☐ Other _____

☐ Slab ☒ Crawl Space ☐ Basement w/plumbing ☐ Basement wo/plumbing

Water Supply: ☐ Individual ☒ Public ☒ Community

Comments:/Conditions: or 36" max 9'oc

Initial site evaluation and system design performed by Paul Pennington and Kathleen Hower of S&ME


Comments/Conditions: Leaked tanks & lines - MD

INITIAL SITE SKETCH

SEE Plan from S&ME

Rd

AS BUILT SKETCH

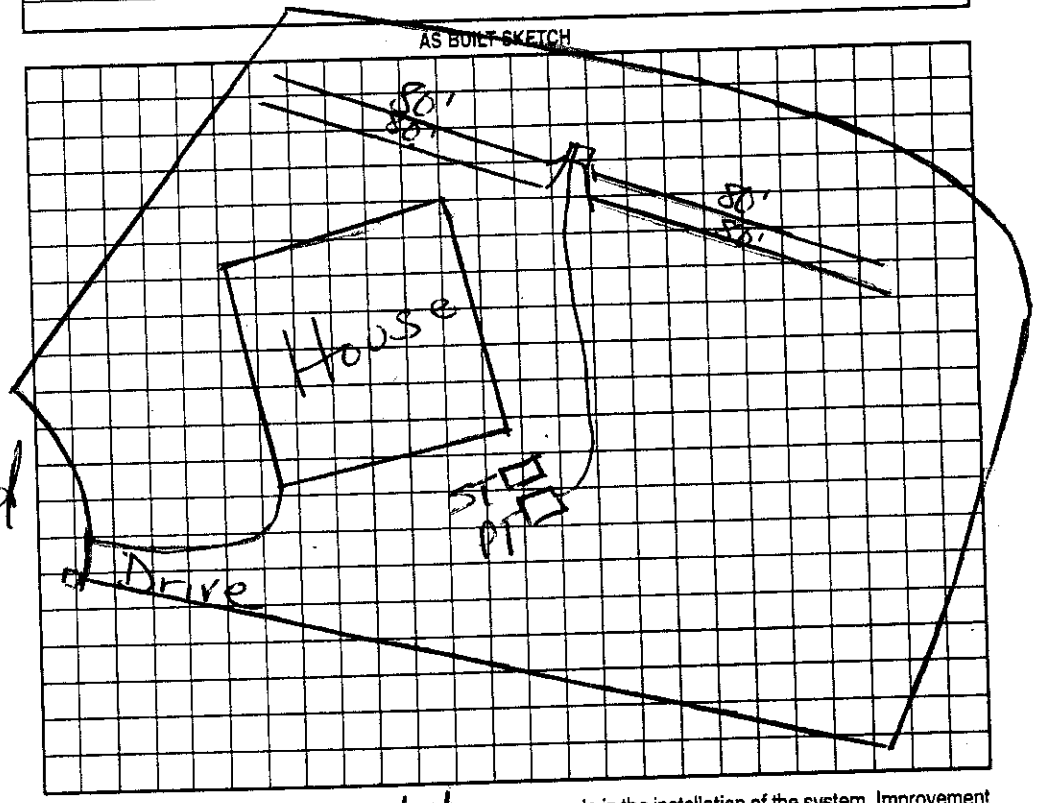

Permit can be suspended or revoked if any false information is supplied toward securing the permit/any unauthorized changes are made to the site/any unauthorized changes are made in the installation of the system. Improvement Permit with plat valid without expiration, Improvement Permit with site plan valid for sixty months. Authorization to Construct is valid for a period equal to that of Improvement Permit – not to exceed sixty months.

Signed: Kathleen Hower date 9/30/05 Installed by: R & H

Improvement Permit by: _____ date 9-29-05 Operation Permit by: Marion Dotson RS date 12/12/06

Authorization to Construct by: Wesley Sparks R.S. date 6/5/06 Existing System Inspection by: _____ date _____

HEALTH DEPT. COPY: WHITE OWNER COPY (FINAL): YELLOW OWNER COPY (INITIAL): PINK