IREDELL COUNTY HEALTH DEPARTMENT

STATESVILLE 704-878-5305 MOORESVILLE 704-664-5281

IMPROVEMENT PERMIT / AUTHORIZATION TO CONSTRUCT / OPERATION PERMIT / EXISTING SYSTEM INSPECTION

PERMIT# 139562 PIN# 4627219744 DATE 12-12-06

OWNER OR APPLICANT STEVE SCHNIEDER PHONE: Business _____ Home _____

ADDRESS 252 LAKEVIEW SHORES LP, MOORESVILLE, 28117

LOCATION BROWLEY SCH RD, RT MXENDEED, RT LAKEVIEW, HOUSE ~½ MILE ON RT

SUBDIVISION CLT (LAKEVIEW SHORES) BLOCK / SECTION C LOT 332 LOT AREA _____ SITE CLASS. _____ DESIGN FLOW 480gpd L.T.A.R. .30 gal/ft²


360 GPD - ONLY 3BR PERMIT OK 10/24/13

Septic Tank: 1000 Gallons; STB _____ Date _____	☐ New System ☐ Repair ☒ Expansion System Type: I II III IV V VI	☐ House/Mod. Home No. Bedrooms 4	Water Supply:
Pump Tank: 1000 Gallons; PT _____ Date _____	System Description: _____	☐ Mobile Home No. Persons ___	☐ Individual
Pump Make: _____ Model _____ Serial No. _____	Repair System Description: _____	☐ Business No. Employees ___	☐ Public
Nitrification Field: No Fields ___ Square Feet _____ Linear Feet _____	Maintenance Agreement Required: ☐ Yes ☐ No	☐ Other _____	☐ Community
No Lines _____ Trench Width _____ Max Trench Bottom Depth _____ Gravel Depth _____ ☐ Gravity ☐ Pressure	☐ Slab ☐ Crawl Space ☐ Basement w/plumbing ☐ Basement wo/plumbing		

Comments:/Conditions: REMOVE EXISTING OLD TANKS, DISPOSE OF PROPERLY - TIE SUPPLY LINE INTO EXISTING DISTRIBUTION DEVICE USING SCHEDULE 40 PRESSURE RATED PIPE


USE EXISTING LINES

INITIAL SITE SKETCH

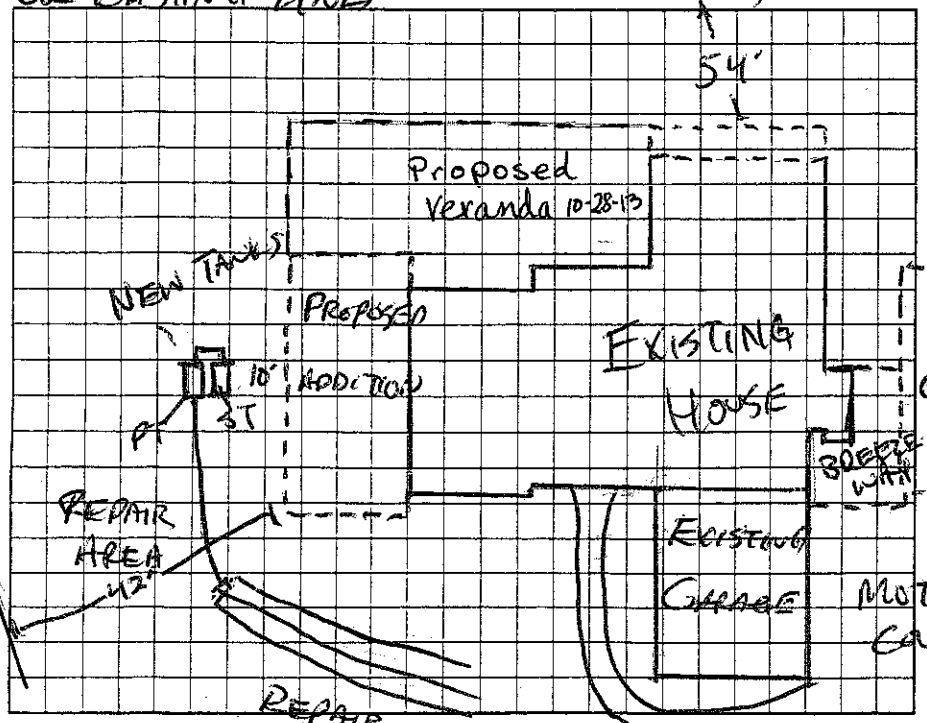

Comments:/Conditions: NEW ADDITIONS DOES NOT HAVE BEDROOMS OR BATHROOMS - MUST RESET PRESSURE HEAD BEFORE COMPLETE

AS BUILT SKETCH

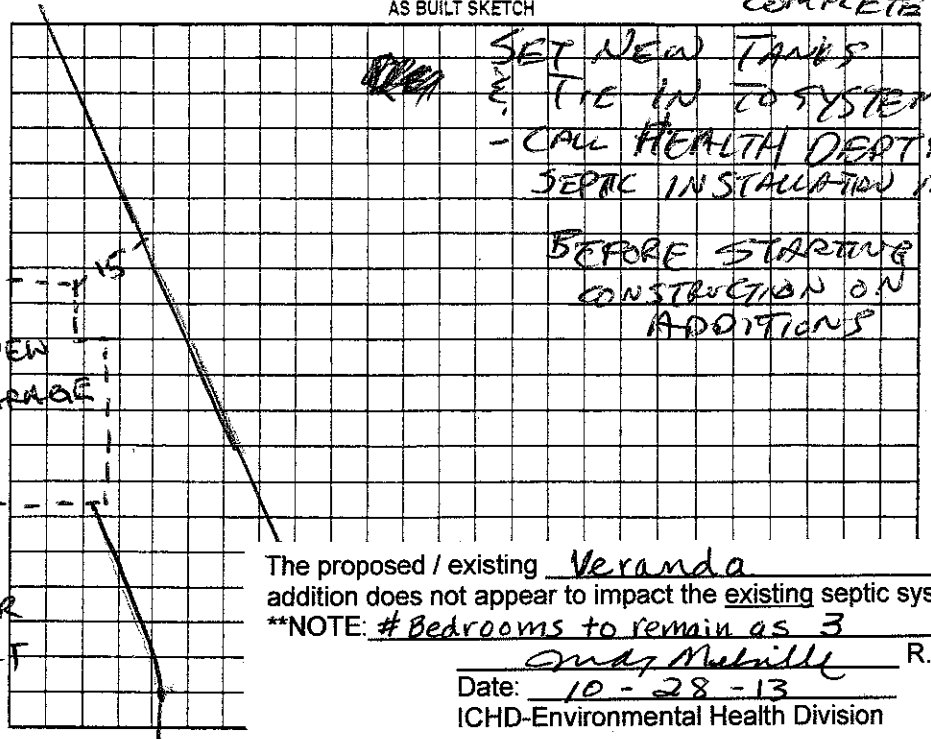

The proposed / existing Veranda addition does not appear to impact the existing septic system.

**NOTE: # Bedrooms to remain as 3

Andy Mehaffey R.S.

Date: 10-28-13

ICHD-Environmental Health Division

Permit can be suspended or revoked if any false information is supplied toward securing the permit/any unauthorized changes are made to the site/any unauthorized changes are made in the installation of the system. Improvement Permit with plat valid without expiration ☐ Improvement Permit with site plan valid for sixty months ☐ Authorization to Construct is valid for a period equal to that of Improvement Permit – not to exceed sixty months.

Signed: Jason Wong date 12/13/06 Installed by: _____

Improvement Permit by: Joseph E Allen date 12-12-06 Operation Permit by: _____ date _____

Authorization to Construct by: Joseph E Allen date 12-12-06 Existing System Inspection by: Joseph E Allen date 12-12-06

HEALTH DEPT. COPY: WHITE OWNER COPY (FINAL): YELLOW OWNER COPY (INITIAL): PINK