4627226143

IREDELL COUNTY HEALTH DEPARTMENT

(SEPTIC TANK) IMPROVEMENTS PERMIT AND CERTIFICATE OF COMPLETION

(Ground Absorption Sewage Disposal System – G. S. Chapter 130-Article 13C)

OWNER OR CONTRACTOR George Melville DATE 7-22-74 PERMIT NO. 193

PHONE: Business _____ Home _____

LOCATION 1100 TR on 1115, Then TR on 1455 next TR on 1456 2nd house on left S. R. No. 1456

SUBDIVISION NAME Lake Norman LOT NO. 316 SECTION OR BLOCK NO. 8

House (✓) Mobile Home ( ) Business ( ) Other _____

No. Bedrooms 3 No. Bathrooms 3

Garbage Disposal Unit Yes (✓) No ( )

Auto. Dishwasher Yes (✓) No ( )

Auto. Wash. Machine Yes (✓) No ( )

Site Suitable Yes (✓) No ( )

Lot Area 30,000 Sq feet


Character & Porosity of Soil Sandy clay loam Porosity Good

Percolation Rate Not taken

Topography 2% Slope

Depth to Water Table 10'+

Rock or other impervious formations 5 to 6' to rock

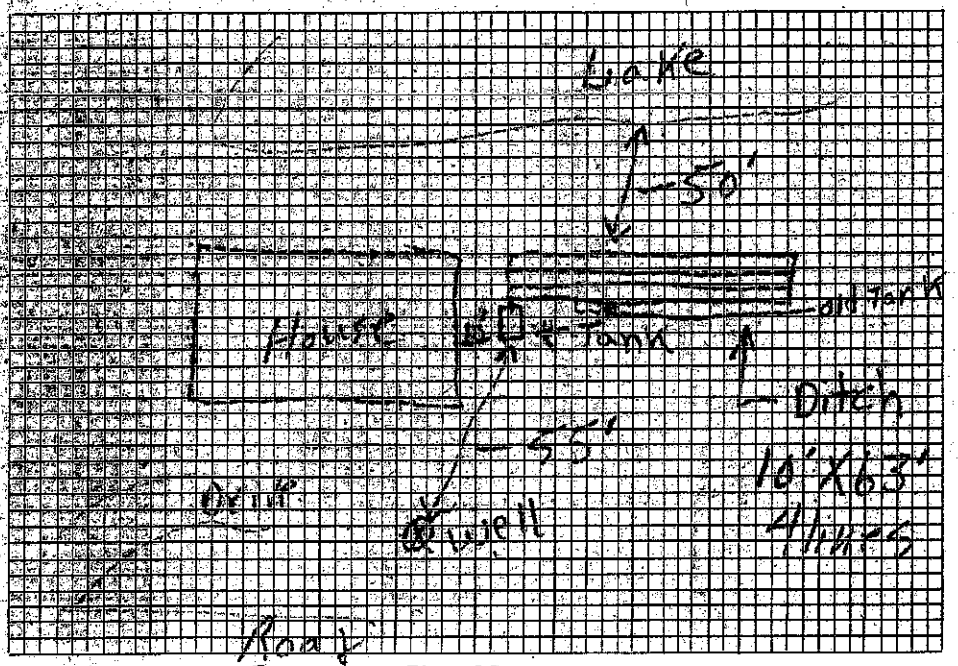

Plot of System

Size of Tank 1250 Gals.

Nitrification Field:

No. of Lines 4

Sq. Ft. 630 Linear Ft. 262

Depth of Stone in Lines 10"

Water Supply: Individual (✓)

Public ( )

Installed by Sam Oswalt

IMPROVEMENTS PERMIT BY J. C. Moore

COMMENTS: Installation went through area where an old system was installed.

CERTIFICATE OF COMPLETION BY J. C. Moore DATE 7-22-74

CONSTRUCTION MUST COMPLY WITH ALL OTHER APPLICABLE STATE AND LOCAL REGULATIONS.

Health Dept. Copy: White Inspection Dept. Copy: Yellow Sanitarian's Copy: Pink Owner's Copy: Gold

4627 22 0143

IREDELL COUNTY HEALTH DEPARTMENT

(SEPTIC TANK) IMPROVEMENTS PERMIT AND CERTIFICATE OF COMPLETION

(Ground Absorption Sewage Disposal System – G. S. Chapter 130-Article 13C)

OWNER OR CONTRACTOR George melville DATE 1-17-74 PERMIT NO. _____

PHONE: Business _____ Home _____

LOCATION 1100 TR on 1115 Then TR on 1455 next TR on 1456 2nd house on left S. R. No. 1456

SUBDIVISION NAME Duke Power LOT NO. 316 SECTION OR BLOCK NO. 5

House ( ) Mobile Home ( ) Business ( ) Other _____

No. Bedrooms 3 No. Bathrooms 3

Garbage Disposal Unit Yes (✓) No ( )

Auto. Dishwasher Yes (✓) No ( )

Auto. Wash. Machine Yes (✓) No ( )

Site Suitable Yes (✓) No ( )

Lot Area 30,000


Character & Porosity of Soil Cecil Sandy loam mix

Percolation Rate not taken

Topography 2 to 6% Slope

Depth to Water Table 10+

Rock or other impervious formations 5 to 15 bedrock

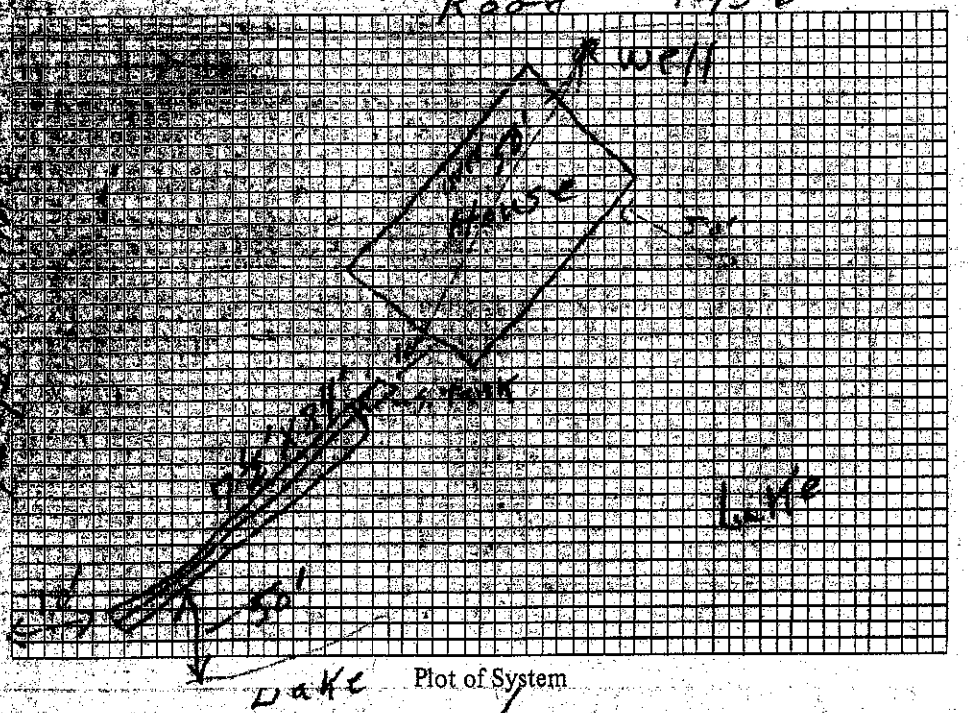

Plot of System

Size of Tank ~~750~~ 1250 Gals.

Nitrification Field:

No. of Lines 3

Sq. Ft. 675 Linear Ft. 250

Depth of Stone in Lines 10"

Water Supply: Individual (✓)

Public ( )

Installed by _____

IMPROVEMENTS PERMIT BY J. C Moore

COMMENTS: _____

CERTIFICATE OF COMPLETION BY _____ DATE _____

CONSTRUCTION MUST COMPLY WITH ALL OTHER APPLICABLE STATE AND LOCAL REGULATIONS.

Health Dept. Copy: White Inspection Dept. Copy: Yellow Sanitarian's Copy: Pink Owner's Copy: Gold