IREDELL COUNTY HEALTH DEPARTMENT

Statesville Phone TR 3-7271 Mooresville Phone NO 3-1271

PERMIT TO INSTALL SEPTIC TANK

Permit No. 47 Permit Date May 27 19 71

Owner Cloninger Address Charlotte, NC

Installed By Robinson + H Address Mooresville, NC


Location of Property Beaty School Rd. Turn Right on #1115 - Right on 3rd Road - Section 8 Lot 318

Tank		Capacity		Length of Lines		Fixtures	
Block	( )	1000	( )	225'	( )	No. of Baths	( )
Precast	( )	1250	( )	250'	( )	Dishwasher	( )
		1500	( )	Other 200 Extra Stone		Garbage Grdr.	( )
		Other				Other	

NOTIFY HEALTH DEPARTMENT AT LEAST EIGHT HOURS BEFORE TANK IS TO BE INSPECTED.

Final Inspection May 27 19 71 Approved ( ) Disapproved ( )

Remarks

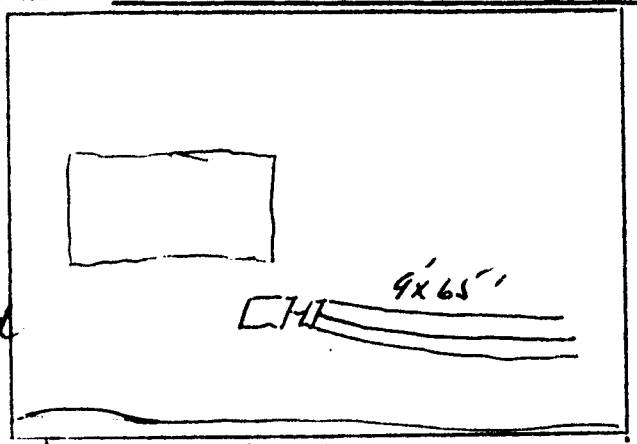

Sketch of Installation

Glenn Todd Jr.

Sanitarian