IREDELL COUNTY HEALTH DEPARTMENT - *ENVIRONMENTAL HEALTH* ☐ STATESVILLE OFFICE 704-878-5305 ☐ MOORESVILLE OFFICE 704-664-5281

IMPROVEMENT PERMIT / AUTHORIZATION TO CONSTRUCT / OPERATION PERMIT / EXISTING SYSTEM INSPECTION

PERMIT # Repair PIN # 4627227484 DATE 9-26-2011

OWNER AW Cloninger APPLICANT: Same PHONE: Home/Cell # 704664-6576 Business #

SITE ADDRESS 131 Goathill Rd OWNER / APPLICANT ADDRESS 131 Goathill Rd M'ville, NC 28117

SITE DIRECTIONS Brawley School Rd TR McKendree TR Lakeshore Dr TR Goathill Rd on left

SUBDIVISION Cl & In Estates BLOCK / SECTION 8 LOT # 318 LOT AREA .76Acre DESIGN FLOW 360gpd L.T.A.R.

Septic Tank 1000 Gallons: STB IM1060 Date

Pump Tank Gallons: P T Date

Pump Make Model Serial #

No. Nitrification Fields: 1 No. Lines Linear Feet ~65'

Trench Width ~9ft Max. Trench Bottom Depth Gravel Depth

☐ New System ☒ Repair ☐ Expansion System Type I (II) III IV V VI

System Description: Gravity - Conventional

Repair System Description: Pre 1983

Maintenance Agreement Required ☐ YES ☒ NO

☒ GRAVITY ☐ PRESSURE

☒ Residence ☐ Business ☐ Other ☐ Slab ☐ Basement w/plumbing


No. Bedrooms 3 No. Persons No. Employees ☐ Crawl Space ☐ Basement w/o plumbing

Water Supply: ☒ Private ☐ Public ☐ Community

Comments / Conditions: Replace existing ST with new ST Very tight location

"Properly abandon" existing ST Connect new ST onto existing Drainfield

INITIAL SITE SKETCH

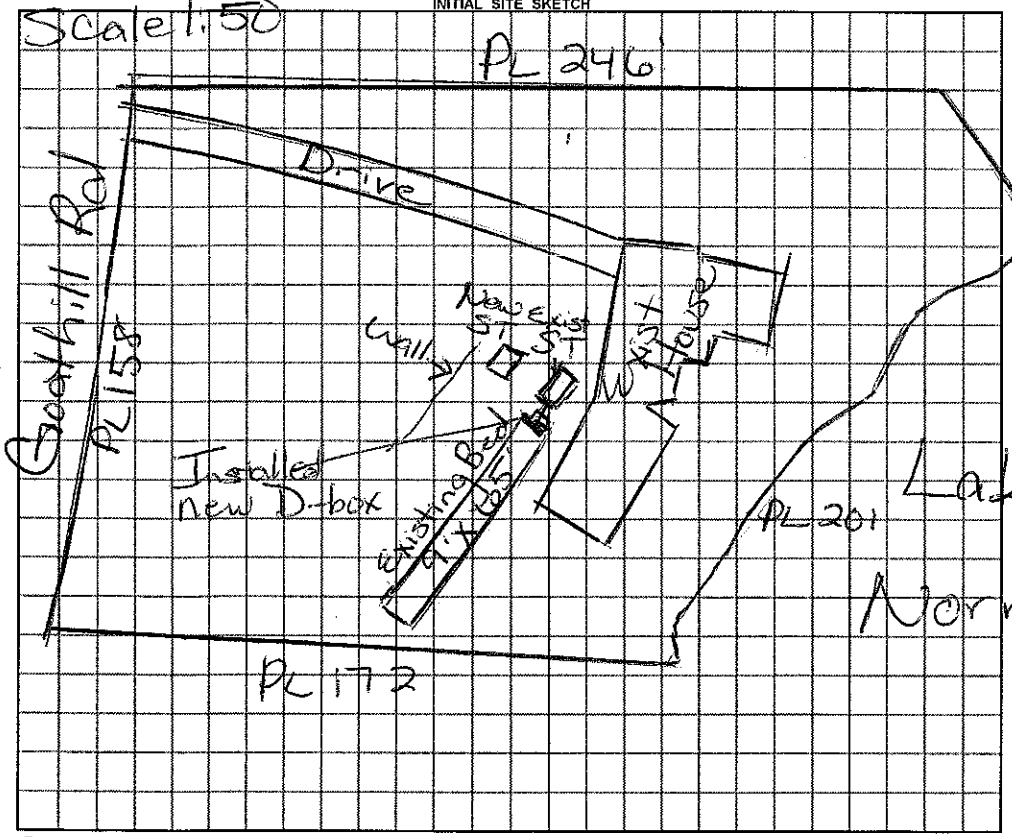

AS BUILT SKETCH

Installed new "Plastic" tank & new Distribution box

Permit can be suspended or revoked if any false information is supplied toward securing the permit / any unauthorized changes are made to the site / any unauthorized changes are made in the installation of the system.

☐ ***IMPROVEMENT PERMIT*** *with plat valid without expiration.* ☐ ***IMPROVEMENT PERMIT*** *with ~~plat valid without expiration.~~ site plan valid 60 mo.* ☐ ***AUTHORIZATION TO CONSTRUCT*** valid for period equal to IMPROVEMENT PERMIT--not to exceed 60 mo.

Owner / Applicant Signature: AW Cloninger Date 9-26-11

IMPROVEMENT PERMIT by: [signature] REHS Date 9/26/11

AUTHORIZATION TO CONSTRUCT by: [signature] REHS Date 9/26/11

YOU SHOULD CONTACT A LOCATOR SERVICE PRIOR TO ANY EXCAVATION

Installed by: C. Wayne Orbison

OPERATION PERMIT by: [signature] REHS Date 9/28/2011

Existing System Inspected by: REHS Date

White Copy – Environmental Health YELLOW COPY (Final) Owner / Applicant PINK COPY (Initial) Owner / Applicant