IREDELL COUNTY HEALTH DEPARTMENT

STATESVILLE 704-878-5305 MOORESVILLE 704-664-5281

IMPROVEMENT PERMIT / AUTHORIZATION TO CONSTRUCT / OPERATION PERMIT / EXISTING SYSTEM INSPECTION

PERMIT # — PIN # 4627-22-9233 DATE April 26, 2010

OWNER or APPLICANT Jessie Smith PHONE: Business 704-575-1833 Home: 704-660-6373

OWNER or APPLICANT ADDRESS 128 Goathill Rd.

LOCATION / DIRECTIONS Brawley Sch. Rd. TR McKendree TR Lakeview Shores Lp. TR Goathill on right

SUBDIVISION CL+T BLOCK / SECTION 8 LOT # 328 LOT AREA .89 Ac DESIGN FLOW 360gpd L.T.A.R. .3gpd/ft²

Septic Tank Existing* Gallons: STB — Date —

Pump Tank 1000 Gallons: PT — Date —

Pump Make Gravity Model WEOSIIH Serial # 4/2HP

Nitrification Field No Fields 1 No Lines 4 Linear Feet 300

Trench Width 36" Max. Trench Bottom Depth 36" Gravel Depth NA

☐ New System ☒ Repair ☐ Expansion System Type I II III IV V VI

System Description: 25% Reduction PM

Repair System Description:

Maintenance Agreement Required ☐ YES ☒ NO

☐ GRAVITY ☒ PRESSURE

☒ Residence No. Bedrooms 3 ☐ Business No. Persons 6 ☐ Other No. Employees — ☐ Slab ☒ Crawl Space ☐ Basement w/plumbing ☐ Basement w/o plumbing

Water Supply: ☒ Private ☐ Public ☐ Community

Comments / Conditions

*May need new tank based on condition

Keep drain lines 5'+ from shed


Keep drainlines 10' from Property lines

Keep supply lines & drainfield 50' from well


Comments / Conditions

INITIAL SITE SKETCH

- Call Health Dept. for Consultation before digging -

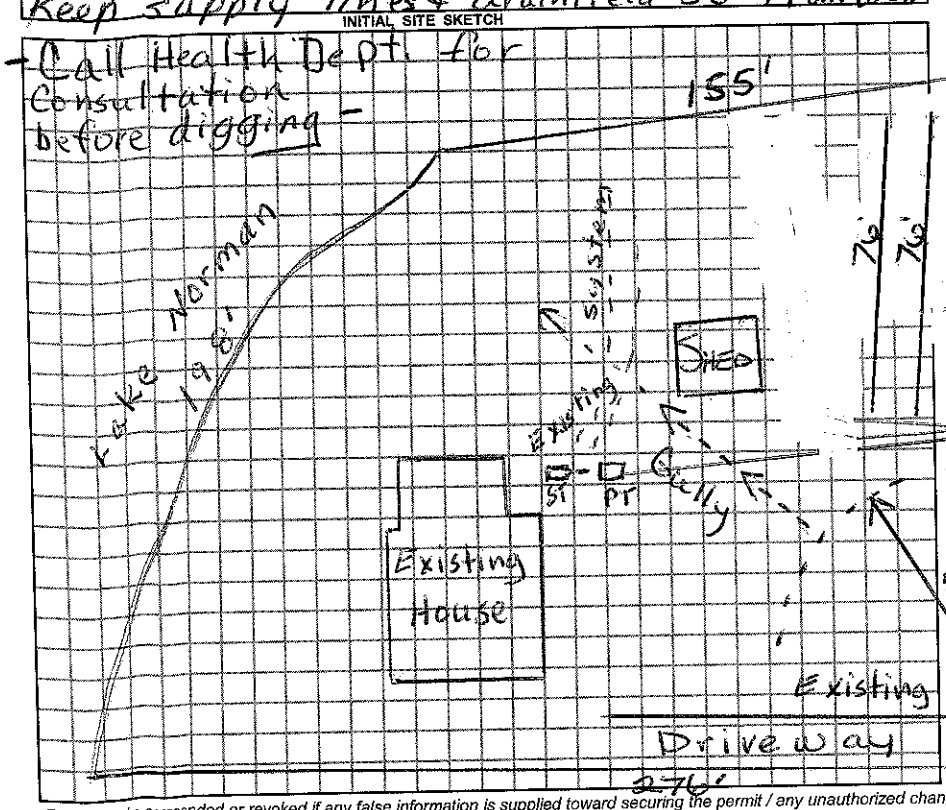

AS BUILT SKETCH

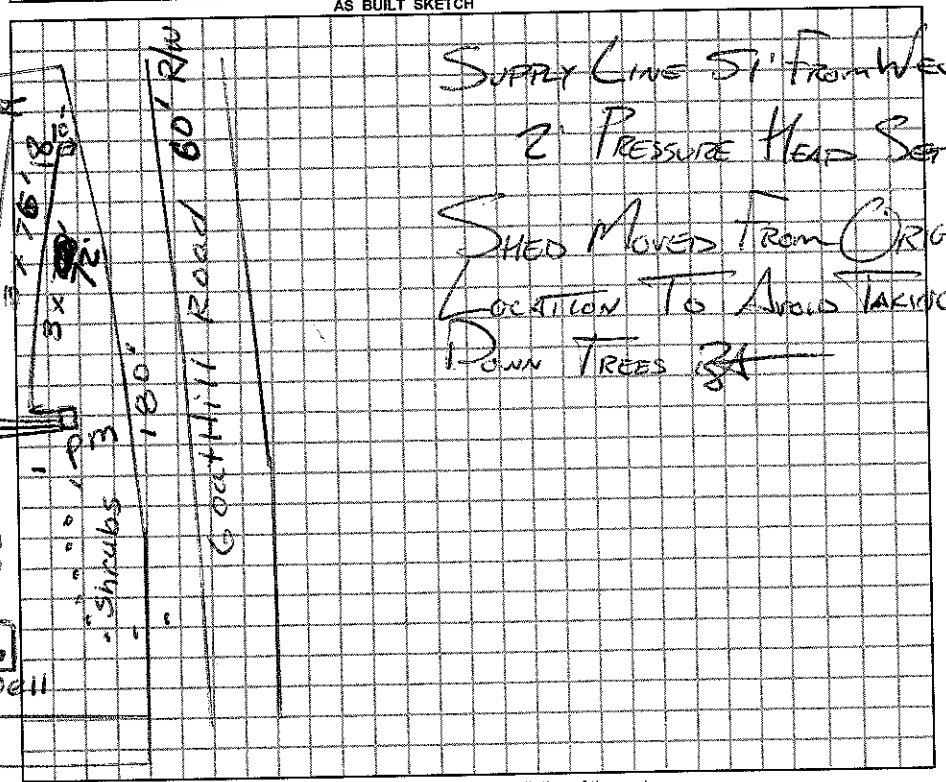

Permit can be suspended or revoked if any false information is supplied toward securing the permit / any unauthorized changes are made to the site / any unauthorized changes are made in the installation of the system.

☐ IMPROVEMENT PERMIT w / plat valid without expiration ☐ IMPROVEMENT PERMIT w / site plan valid for 60 mos. ☐ AUTHORIZATION TO CONSTRUCT valid for period equal to IMPROVEMENT PERMIT-not to exceed 60 mo.

Owner / Applicant Signature: Jessie Smith Date 4-28-10

Permit by: Judy Melville Date 4-26-10

to Construct by: Judy Melville Date 4-26-10

Installed by: A-1 Backhoe

Operation Permit by: [signature] Date: 5-19-10

Existing System Inspected by: Date:

SHOULD CONTACT A LOCATOR SERVICE PRIOR TO ANY EXCAVATION.

WHITE COPY Environmental Health YELLOW COPY (Final) Owner / Applicant PINK COPY (Initial) Owner / Applicant