IREDELL COUNTY HEALTH DEPARTMENT

Authorization to Construct

STATESVILLE 704-878-5305 MOORESVILLE 704-664-5281

IMPROVEMENT PERMIT / CERTIFICATE OF COMPLETION / OPERATION PERMIT / EXISTING SYSTEM INSPECTION

PROPERTY DESCRIPTION NO. 23583 DATE 11/20/96 TAX MAP NO. 2L 3A 321 4627229798 Watershed: X Yes ☐ No

OWNER OR CONTRACTOR Mike Griffin PHONE: Business 664-9111 Home

ADDRESS PO Box 1357 Mooresville, NC. 28115

LOCATION Foothill Rd - Brawley TR McKendree TR Lakeview TR Foothill on (L) cul de sac

SUBDIVISION CL+T BLOCK / SECTION 8 LOT 32 LOT AREA .8 Ac SITE CLASS. PS DESIGN FLOW 480 L.T.A.R. .3

Septic Tank: 1000 Gallons; STB 794 Date 3/27/97

Pump Tank: 1000 Gallons; PT 27 Date

Pump Make: Bad Le Model WEE511H Serial No. B9708810

Nitrification Field: No Fields 1 Square Feet 534* Linear Feet 267*

No Lines 4 Trench Width 24" Max Trench Bottom Depth 36" Gravel Depth SAND

X New System ☐ Repair System Type: I, II, III, IV, V, VI

System Description: PRESMAN → 16" PPBS

Repair System Description: SAME

Maintenance Agreement Required: ☐ Yes X No

X House/Mod. Home ☐ Mobile Home ☐ Business ☐ Other

No. Bedrooms 4 No. Bathrooms 3.5 No. Employees


Water Supply: X Individual ☐ Community ☐ Public

☐ Slab ☐ Crawl Space X Basement w/plumbing ☐ Basement wo/plumbing


Comments: LN 1" = 40' 760 CONTOUR

Comments: 55 1.5 .75

INITIAL SITE SKETCH

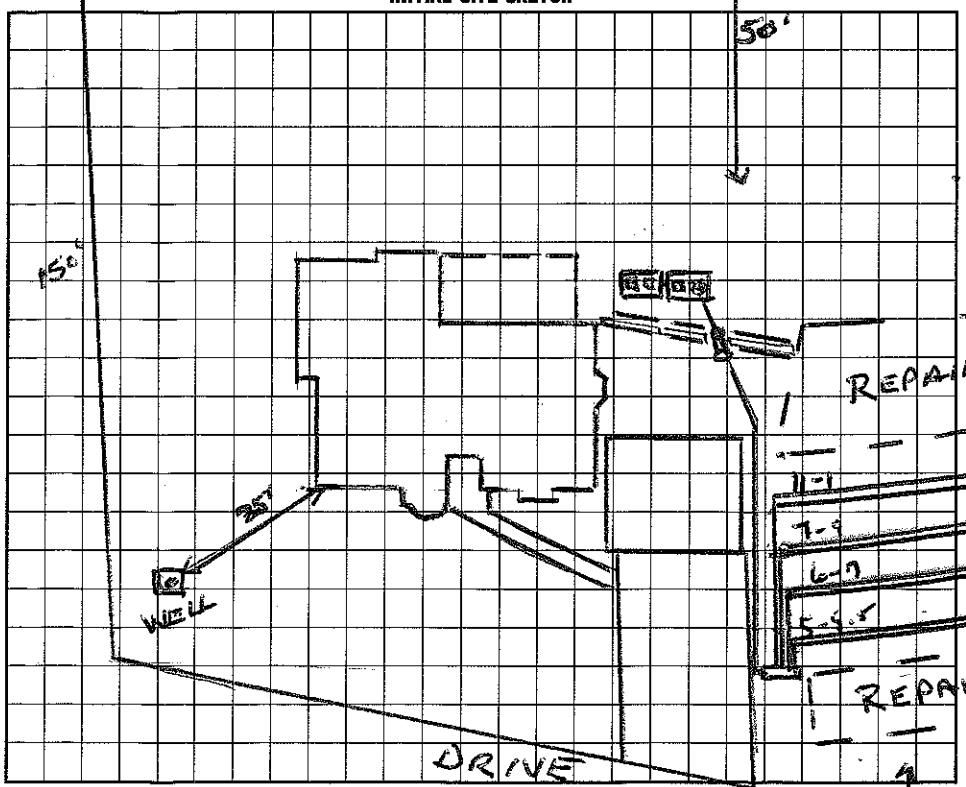

AS BUILT SKETCH

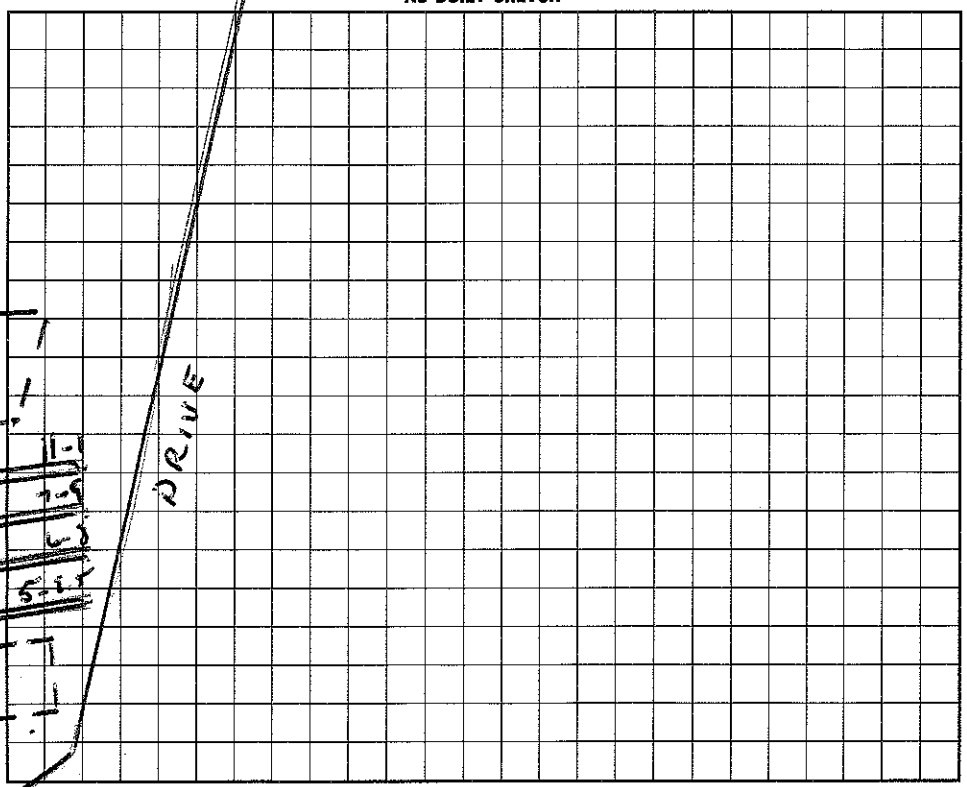

I understand that this permit can be suspended or revoked if any false information is supplied toward securing the permit, any unauthorized changes are made to the site/any unauthorized changes are made in the installation of the system.

Signed: Bonnie Rochelle

Improvement Permit by: Wesley Sparks RS. date 11/20/96

Existing System Inspection by: Wesley Sparks RS. date 11/20/96

Installed by: CW DZ SAC FJ Ervin

Certificate of Completion by: Wesley Sparks RS. date 10/6/97

Operation Permit by: Wesley Sparks RS. date 10/6/97

HEALTH DEPT. COPY: WHITE INSPECTION COPY (FINAL): GREEN OWNER COPY (FINAL): YELLOW INSPECTION COPY (INITIAL): PINK OWNER COPY (INITIAL): GOLD