IREDELL COUNTY HEALTH DEPARTMENT

STATESVILLE 704-878-5305 550.00 Paid MOORESVILLE 704-664-5281

IMPROVEMENT PERMIT / AUTHORIZATION TO CONSTRUCT / OPERATION PERMIT / EXISTING SYSTEM INSPECTION

PERMIT# 136087 PIN# 4627300845 DATE 8-14-06

OWNER OR APPLICANT Elizabeth Roberts / Jeffrey Roberts PHONE: Business _____ Home 336-924-0383 or 704-664-1278

ADDRESS 4209 Hunting Meet Court Pfafftown 27040

LOCATION Brawley School Rd TR Mckendrie TR Lakeview Shores Lp (212 Lakeview Shores Lp)

SUBDIVISION C14 BLOCK / SECTION 8 LOT 340 LOT AREA .631 Ac SITE CLASS. PS DESIGN FLOW 360gpd L.T.A.R. .3gpd/ft²

Septic Tank: 1000 Gallons: STB 8925 Date 4/30/07

Pump Tank: 1000 Gallons: PT 307 Date 3/17/05

Pump Make: ZOELLER Model N-98 Serial No. 06

Nitrification Field: No Fields 1 Square Feet 1200 Linear Feet 200

No Lines X 3 Trench Width 24" Max Trench Bottom Depth 36"

☒ New System ☐ Repair ☐ Expansion System Type: I II III (IV) V VI

System Description: LP PPBPS

Repair System Description: LP PPBS

Maintenance Agreement Required: ☒ Yes ☐ No

☒ House/Mod. Home No. Bedrooms 3

☐ Mobile Home No. Persons ____

☐ Business No. Employees ____

☐ Other ____

Water Supply: ☒ Individual ☐ Public ☐ Community

Gravel Depth NA ☐ Gravity ☒ Pressure ☐ Slab ☐ Crawl Space ☐ Basement w/plumbing ☒ Basement wo/plumbing

Comments/Conditions:


1) House moved 8' back towards road from site plan.

2) Before AC issued gravel & fill to be removed from system area.

3) Properly abandon 1997.80 existing system


INITIAL SITE SKETCH

1" = 40'

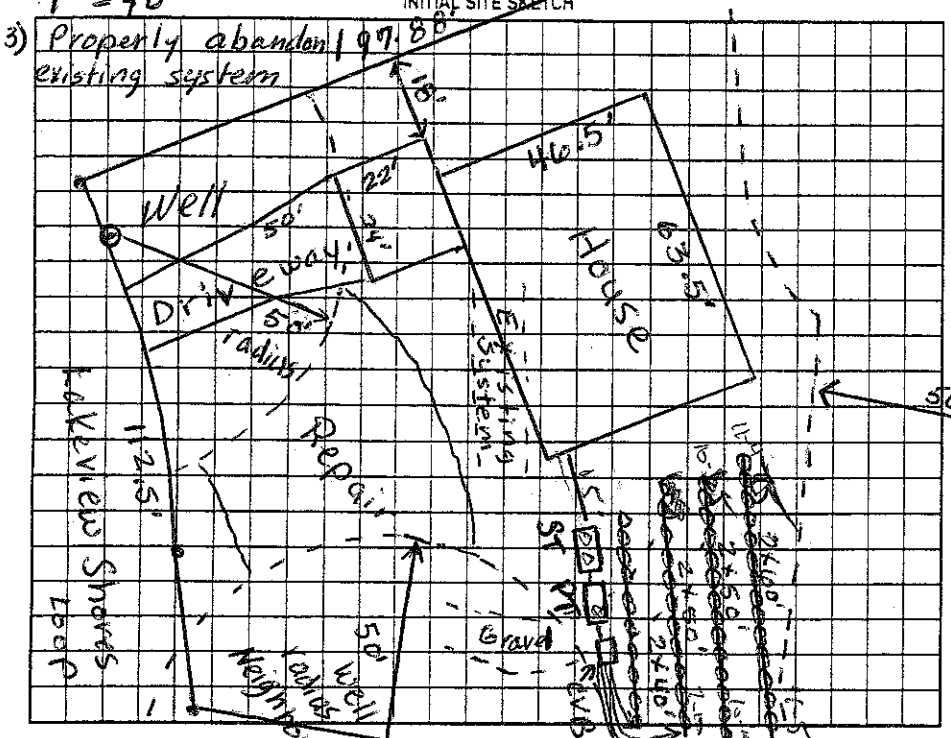

Comments/Conditions:

AS BUILT SKETCH

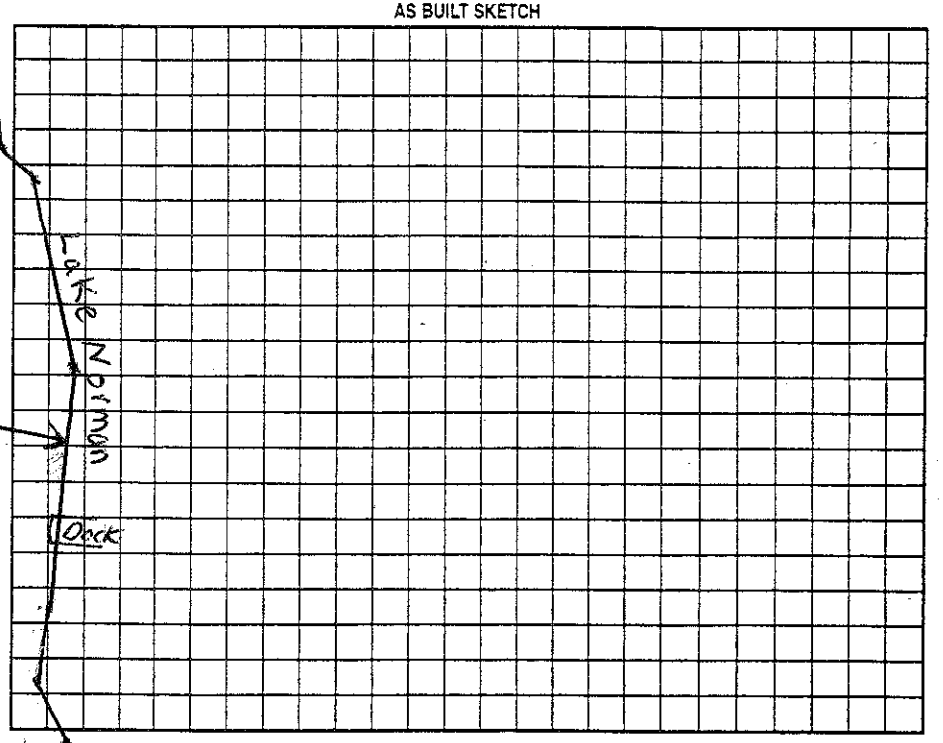

Permit can be suspended or revoked if any false information is supplied toward securing the permit/any unauthorized changes are made to the site/any unauthorized changes are made in the installation of the system. Improvement Permit with plat valid without expiration ☐ Improvement Permit with site plan valid for sixty months ☐ Authorization to Construct is valid for a period equal to that of Improvement Permit – not to exceed sixty months.

Signed: Elizabeth Roberts date 8-31-06 Installed by: Rawson Septic Tank + Ditching

Improvement Permit by: Judy Melville date 8-14-06 Operation Permit by: Wesley Sparks RS date 6/5/07

Authorization to Construct by: Judy Melville date 8-31-06 Existing System Inspection by: _____ date _____

HEALTH DEPT. COPY: WHITE OWNER COPY (FINAL): YELLOW OWNER COPY (INITIAL): PINK