IREDELL COUNTY HEALTH DEPARTMENT

STATESVILLE 704-878-5305 280.00 Paid MOORESVILLE 704-664-5281

IMPROVEMENT PERMIT / AUTHORIZATION TO CONSTRUCT / OPERATION PERMIT / EXISTING SYSTEM INSPECTION

PERMIT# 094799 PIN# 4627320361 Jeff Tony 791-6422 DATE 4-5-2002

OWNER OR CONTRACTOR Jeff and Terry Fink PHONE: Business 236-2680 Home 664-9820

ADDRESS 157 Malibu Rd Mooresville, NC 28117

LOCATION Brawley School Rd TR McKendree TR Lakeview Shore Lp TR Goat Hill

SUBDIVISION Cla K BLOCK / SECTION 8 LOT 327 LOT AREA .86 Acre SITE CLASS. RS DESIGN FLOW 480gpd L.T.A.R. .3+

Septic Tank: 1000 Gallons; STB 312 Date 6-11-02

Pump Tank: _____ Gallons; PT _____ Date _____

Pump Make: _____ Model _____ Serial No. _____

Nitrification Field: No Fields 1 Square Feet 1200' Linear Feet 400'

No Lines 4 Trench Width 36" Max Trench Bottom Depth 36" Gravel Depth N/A

[X] New System [ ] Repair System Type: I, II, III, IV, V, VI

System Description: Gravity-25% Reduction

Repair System Description: Rmp-Innovative

Maintenance Agreement Required: [ ] Yes [X] No

[X] House/Mod. Home No. Bedrooms 4

[ ] Mobile Home No. Bathrooms 3.5

[ ] Business No. Employees _____

[ ] Other _____


[ ] Slab [ ] Crawl Space [ ] Basement w/plumbing [ ] Basement wo/plumbing

Water Supply: [X] Individual [ ] Public [ ] Community


Comments:/Conditions: Abandon existing Septic tank per Iredell Co. Inspection rules. Direct new drainlines around former tank pit. Keep Septic System at least 10' From PL & 50' From lake.

Comments:/Conditions: * Note: If existing Septic tank is in good Condition and gravity flow can be maintained to upper drainline then existing ST can be used.

INITIAL SITE SKETCH Scale 1:50

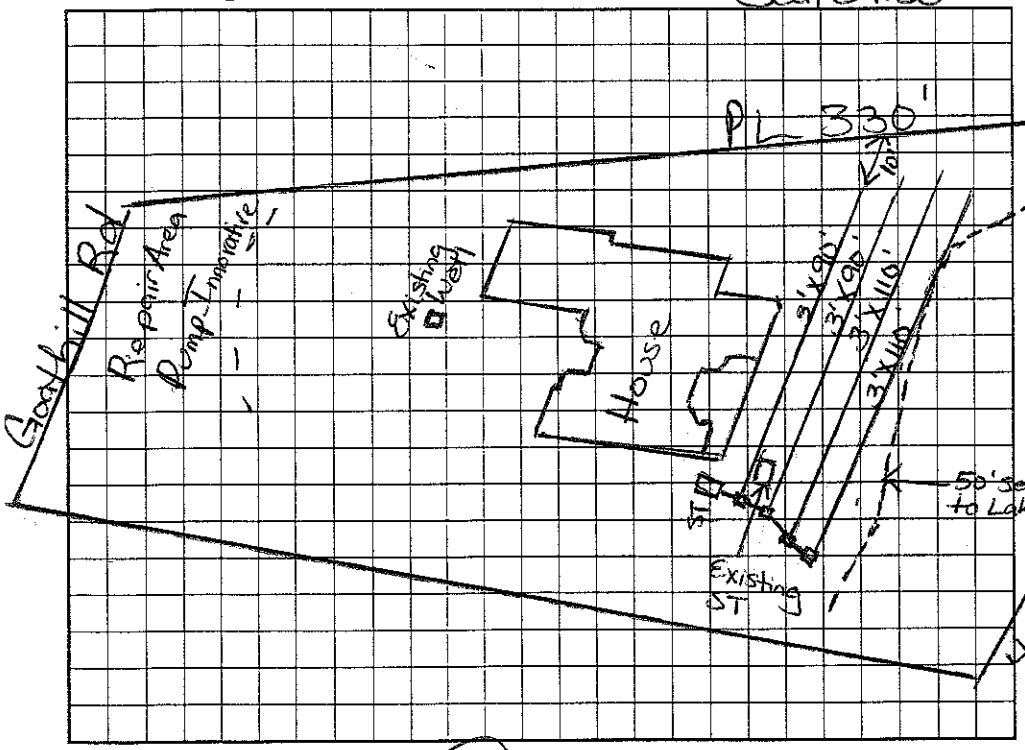

AS BUILT SKETCH

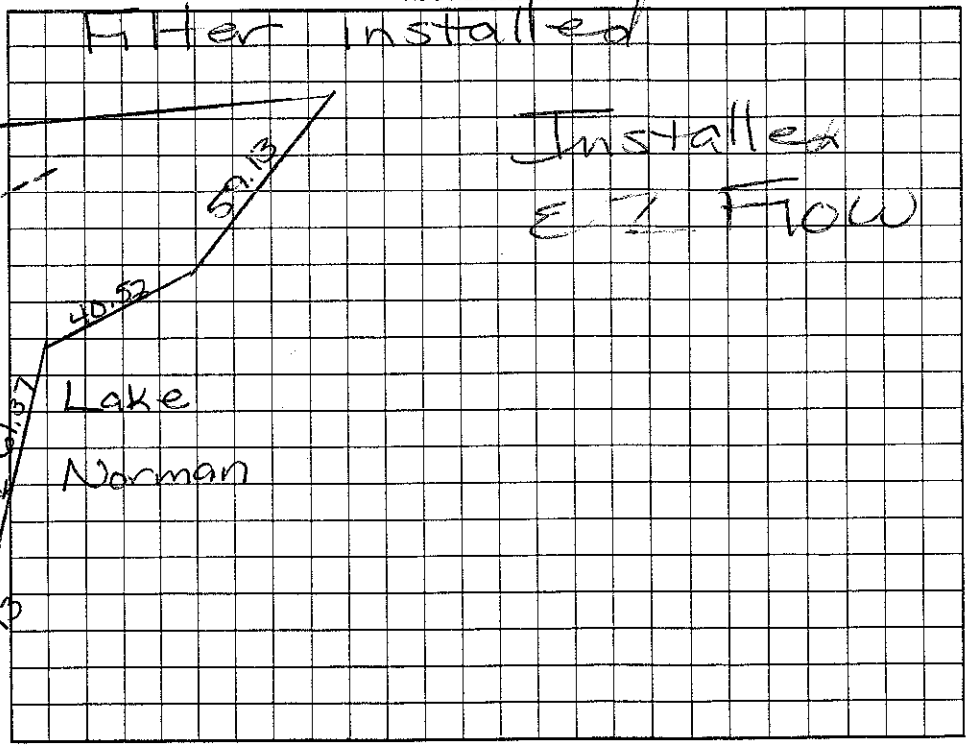

Permit can be suspended or revoked if any false information is supplied toward securing the permit/any unauthorized changes are made to the site/any unauthorized changes are made in the installation of the system. Improvement Permit with plat valid without expiration. Improvement Permit with site plan valid for sixty months. Authorization to Construct is valid for a period equal to that of Improvement Permit – not to exceed sixty months.

Signed: _____ date 4/5/02 Installed by: C. Wayne Orbison RS

Improvement Permit by: Maria H. Dotson RS date 4/5/2002 Operation Permit by: Maria H. Dotson date 9/25/2002

Authorization to Construct by: Maria H. Dotson RS date 4/5/2002 Existing System Inspection by: _____ date _____

HEALTH DEPT. COPY: WHITE OWNER COPY (FINAL): YELLOW OWNER COPY (INITIAL): PINK