IREDELL COUNTY HEALTH DEPARTMENT

Statesville Phone TR 3-7271 — Mooresville Phone NO 3-1271

PERMIT TO INSTALL SEPTIC TANK

Permit No. 76 — Permit Date 7-7 1971

Owner L.P. Sloan [redacted] INC — Address

Installed By Addison & H. — Address Mooresville, NC.

Location of Property


Section 8 - Lot #325

Tank		Capacity		Length of Lines		Fixtures	
Block	( )	1000	(✓)	225'	(✓)	No. of Baths	(✓)
Precast	(✓)	1250	( )	250'	( )	Dishwasher	( )
		1500	( )	Other		Garbage Grdr.	( )
		Other				Other	

NOTIFY HEALTH DEPARTMENT AT LEAST EIGHT HOURS BEFORE TANK IS TO BE INSPECTED.

Final Inspection 7-7 1971 — Approved (✓) Disapproved ( )

Remarks

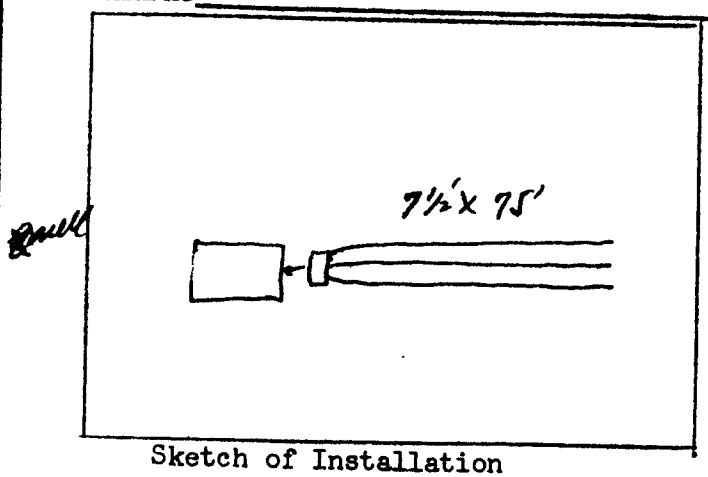

Sketch of Installation

Trees Crowd Nitrification Field

Sanitarian