IREDELL COUNTY HEALTH DEPARTMENT

STATESVILLE 704-878-5305 MOORESVILLE 704-664-5281

IMPROVEMENT PERMIT / AUTHORIZATION TO CONSTRUCT / OPERATION PERMIT / EXISTING SYSTEM INSPECTION

PERMIT# 076569 PIN# 4627 32 2855 DATE 10/13/98

OWNER OR CONTRACTOR Sharon N Ruark PHONE: Business NONE Home

ADDRESS 302 Performance Rd. Mooresville, NC. 28115

LOCATION 1100 TR ME Kendrick TR Lakeview Shore TR Boat Hill, onto gravel next to last lot on (R)

SUBDIVISION CL+T BLOCK / SECTION 8 LOT 323 LOT AREA .69 Ac SITE CLASS. PS DESIGN FLOW 360 L.T.A.R. .3

Septic Tank: 1000 Gallons; STB 825 Date 9/1/98
Pump Tank: Gallons; PT Date
Pump Make: Model Serial No.
Nitrification Field: No Fields 1 Square Feet 600 Linear Feet 200 X
No Lines 4@50'x3' Trench Width 36" Max Trench Bottom Depth 32" Gravel Depth SAND

☒ New System ☐ Repair System Type: I, II, (III) IV, V, VI
System Description: GRAVITY - 16" PPBS
Repair System Description: < 1983 - 100% NOT REQ.
Maintenance Agreement Required: ☐ Yes ☒ No


☒ House/Mod. Home No. Bedrooms 3
☐ Mobile Home No. Bathrooms 3
☐ Business No. Employees
☐ Other
☐ Slab ☐ Crawl Space ☒ Basement w/plumbing PARTIAL ☐ Basement wo/plumbing

Water Supply: ☒ Individual ☐ Public ☐ Community


Comments:/Conditions: X 50% reduction for 16" PPBS use ONLY 200 LINEAR FEET REQUIRED.

Comments:/Conditions:

INITIAL SITE SKETCH

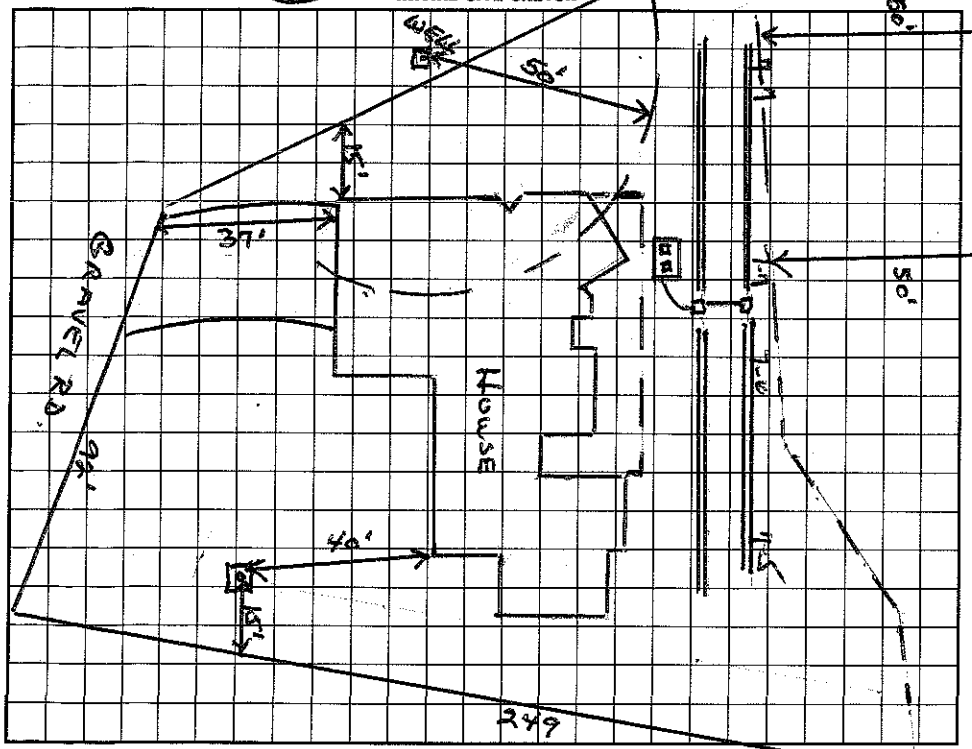

AS BUILT SKETCH

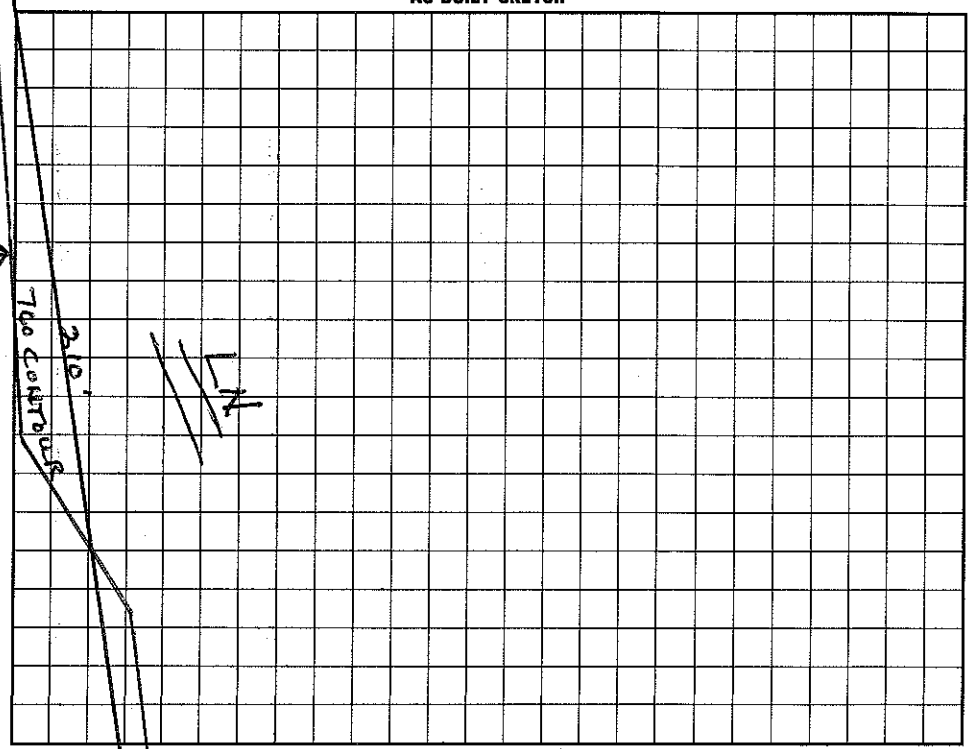

I understand that this permit can be suspended or revoked if any false information is supplied toward securing the permit/any unauthorized changes are made to the site/any unauthorized changes are made in the installation of the system. Improvement Permit with plat valid without expiration. Improvement Permit with site plan valid for sixty months. Authorization to Construct is valid for a period equal to that of Improvement Permit – not to exceed sixty months.

Signed: X date 10/14/98 Installed by: K + K Grading

Improvement Permit by: Wesley Sparks RS. date 10/13/98 Operation Permit by: Wesley Sparks RS date 11/16/98

Authorization to Construct by: Wesley Sparks RS. date 10/13/98 Existing System Inspection by: date

HEALTH DEPT. COPY: WHITE INSPECTION COPY (FINAL): GREEN OWNER COPY (FINAL): YELLOW INSPECTION COPY (INITIAL): PINK OWNER COPY (INITIAL): GOLD