IREDELL COUNTY HEALTH DEPARTMENT

STATESVILLE 704-878-5305 MOORESVILLE 704-664-3281

IMPROVEMENT PERMIT / CERTIFICATE OF COMPLETION / OPERATION PERMIT / EXISTING SYSTEM INSPECTION

PROPERTY DESCRIPTION NO. 067195 DATE 6/5/97 TAX MAP NO. 4627396974 Watershed: [X] Yes [ ] No

OWNER OR CONTRACTOR Douglas M Taylor PHONE: Business N/A Home

ADDRESS 2121 Forsythia Ln. Charlottesville Va. - Mariner Pointe Ln.

LOCATION 150 W TL Mariner Point on (R) before cul de sac

SUBDIVISION Pinnacle Shore BLOCK / SECTION III LOT 43 LOT AREA .924 SITE CLASS PS DESIGN FLOW 360 L.T.A.R. .3

Septic Tank: 1000 Gallons; STB 794 Date 4/12/97

Pump Tank: Gallons; PT Date

Pump Make: Model Serial No.

Nitrification Field: No Fields 1 Square Feet 1200 Linear Feet 400

No Lines 05 Trench Width 36" Max Trench Bottom Depth 36" Gravel Depth 12"

[X] New System [ ] Repair System Type: I, II, III, IV, V, VI

System Description: Low - Conventional

Repair System Description:

Maintenance Agreement Required: [ ] Yes [ ] No

[X] House/Mod. Home No. Bedrooms 3

[ ] Mobile Home No. Bathrooms 2

[ ] Business No. Employees

[ ] Other


[ ] Slab [X] Crawl Space [ ] Basement w/plumbing [ ] Basement wo/plumbing

Water Supply: [ ] Individual [X] Community [ ] Public


Comments:

Comments:

INITIAL SITE SKETCH

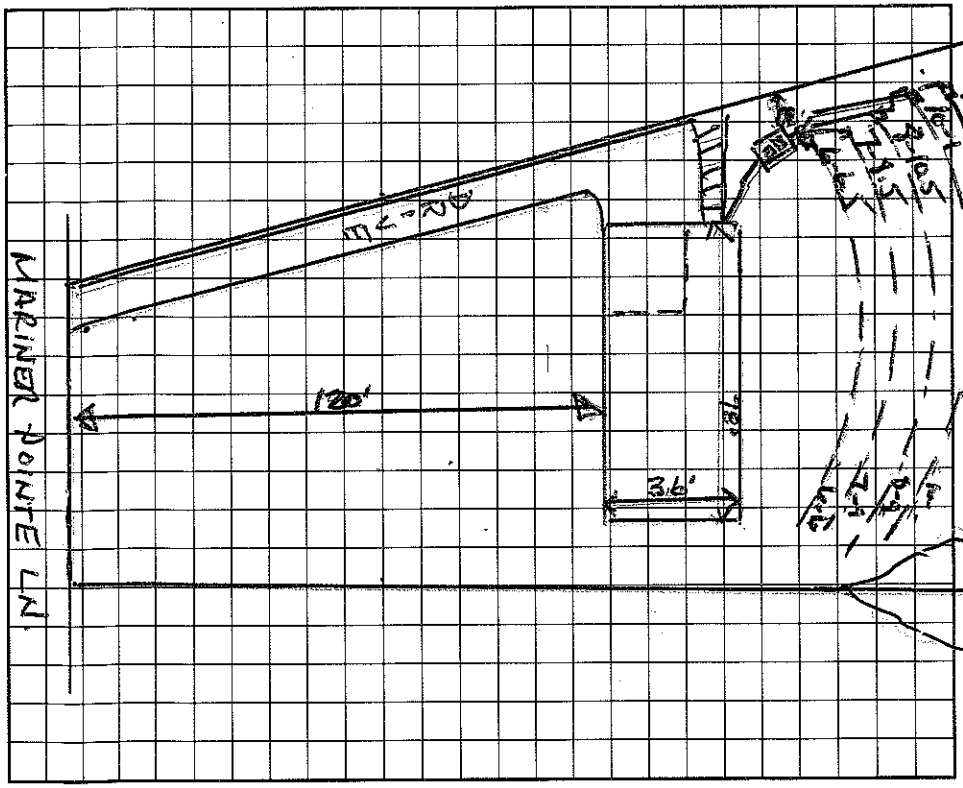

AS BUILT SKETCH

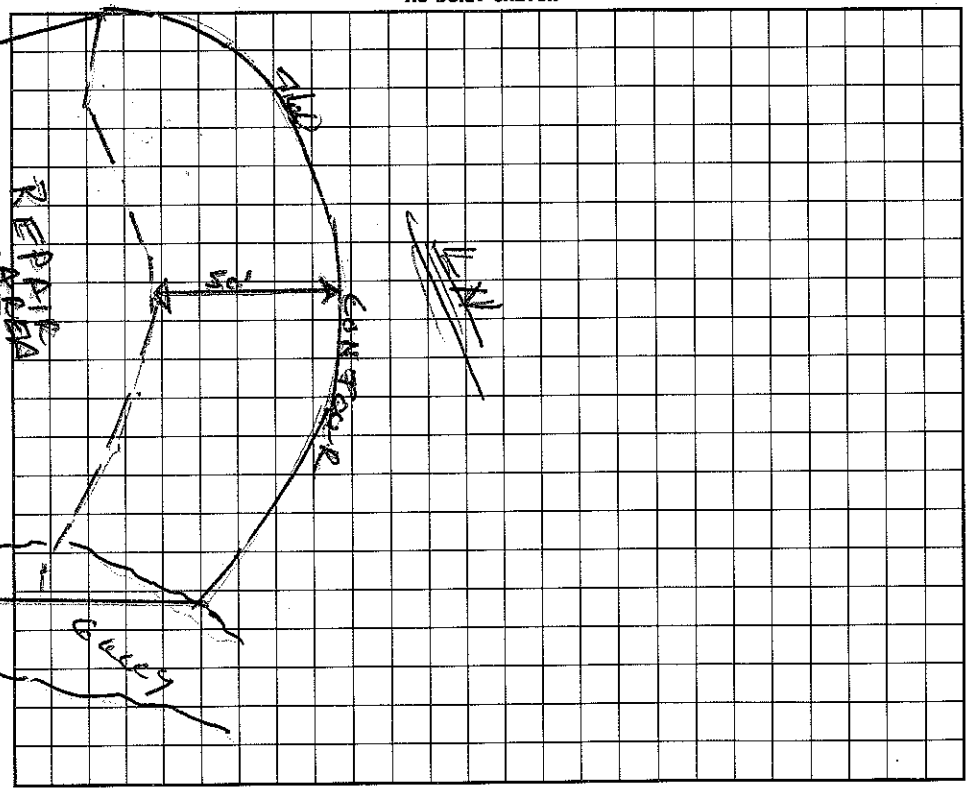

I understand that this permit can be suspended or revoked if any false information is supplied toward securing the permit/any unauthorized changes are made to the site/any unauthorized changes are made in the installation of the system. Improvement Permit is valid for 60 months from date of issuance.

Signed: Kenneth D Ellenz

Improvement Permit by: Wesley Hawks R.S. date 6/4/97

Existing System Inspection by: Wesley Hawks R.S. date 6/4/97

Installed by: Roddy Long Grading

Certificate of Completion by: Wesley Hawks R.S. date 3/20/98

Operation Permit by: Wesley Hawks R.S. date 3/20/98

HEALTH DEPT. COPY: WHITE INSPECTION COPY (FINAL): GREEN OWNER COPY (FINAL): YELLOW INSPECTION COPY (INITIAL): PINK OWNER COPY (INITIAL): GOLD