IREDELL COUNTY HEALTH DEPARTMENT

STATESVILLE 704-878-5305 MOORESVILLE 704-664-5281

195.00 Paid

IMPROVEMENT PERMIT / AUTHORIZATION TO CONSTRUCT / OPERATION PERMIT / EXISTING SYSTEM INSPECTION

PERMIT# 108546 PIN# 4627 39 8595 DATE 8/18/04

OWNER OR CONTRACTOR BO of NC PHONE: Business 704-696-2663 Home

ADDRESS 249 Williamson Rd. Mooresville NC. 28117

LOCATION Mariner Point Ln. 150 W. to Mariner Pt. to Cul de sac onto gravel to house location at lake

SUBDIVISION Pinnacle Shores BLOCK / SECTION 3 LOT 16 LOT AREA 6.1AC SITE CLASS. PS DESIGN FLOW 720 L.T.A.R. .3

Septic Tank: (1) 1500 (1) 1000 Gallons; STB $21 355 Date 4/15/05 3/10/05

Pump Tank: (1) 1500 Gallons; PT 355 Date 2/3/01

Pump Make: ZOELLER Model N-185 Serial No.

Nitrification Field: No Fields 1 Square Feet 800/1200 Linear Feet 400

No Lines 2@150' 1@100' Trench Width 2-3' Max Trench Bottom Depth 3' Gravel Depth No

☒ New System ☐ Repair System Type: I, II, III, IV, V, VI

System Description: Pres Dosed - 1½" PPBPS

Repair System Description: Same System

Maintenance Agreement Required: ☒ Yes ☐ No

☒ House/Mod. Home No. Bedrooms 4

☐ Mobile Home No. Bathrooms 3

☐ Business No. Employees

☒ Other 2BD GARAGE

☐ Slab ☐ Crawl Space ☐ Basement w/plumbing ☐ Basement wo/plumbing


Water Supply: ☐ Individual ☐ Public ☒ Community Pinnacle Shores

Comments:/Conditions:


Comments:/Conditions:

(1" = 100')

INITIAL SITE SKETCH

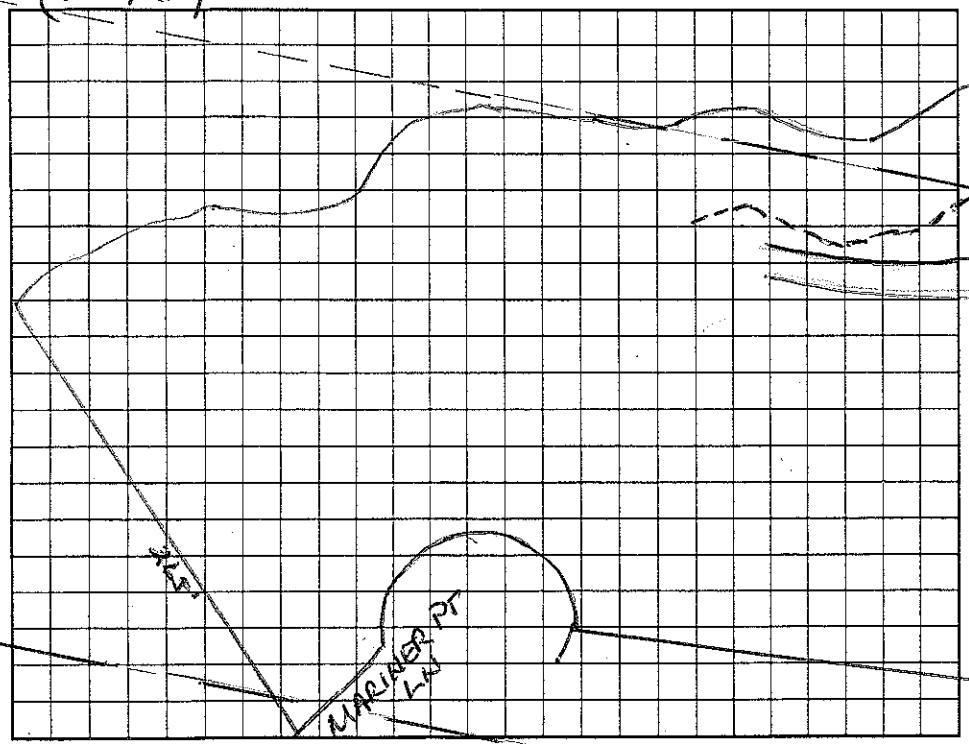

AS-BUILT SKETCH

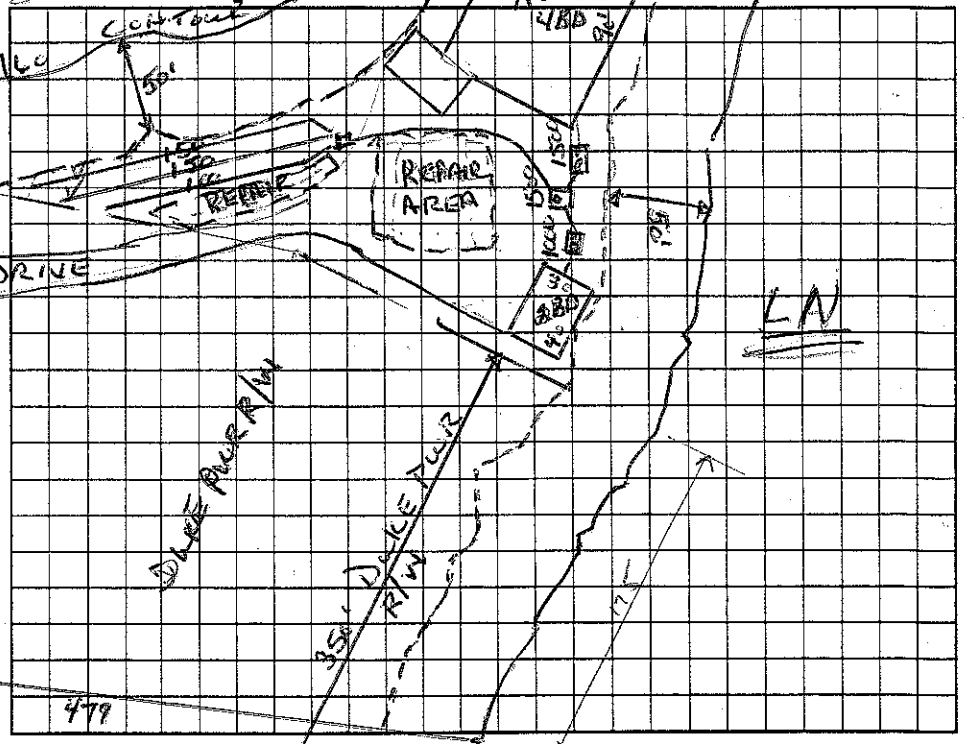

Permit can be suspended or revoked if any false information is supplied toward securing the permit/any unauthorized changes are made to the site/any unauthorized changes are made in the installation of the system. Improvement Permit with plat valid without expiration. Improvement Permit with site plan valid for sixty months. Authorization to Construct is valid for a period equal to that of Improvement Permit – not to exceed sixty months.

Signed: X Diane Kavallaris date 8-2004 Installed by: B&M Enterprises

Improvement Permit by: Wesley Sparks R.S. date 8/18/04 Operation Permit by: Wesley Sparks R.S. date 6/2/05

Authorization to Construct by: Wesley Sparks R.S. date 8/18/04 Existing System Inspection by: date

HEALTH DEPT. COPY: WHITE OWNER COPY (FINAL): YELLOW OWNER COPY (INITIAL): PINK