IREDELL COUNTY HEALTH DEPARTMENT

STATESVILLE 704-878-5305 MOORESVILLE 704-664-5281

IMPROVEMENT PERMIT / AUTHORIZATION TO CONSTRUCT / OPERATION PERMIT / EXISTING SYSTEM INSPECTION

PERMIT# 140024 PIN# 4627 40 4796.617 4627402449 Renee DATE March 8, 2007

OWNER OR APPLICANT The Farms LLC Craig Carter PHONE: Business _____ Home 336 940 2341

ADDRESS 2214 Brawley Sch Rd, Mooresville, N.C. 28117

LOCATION Brawley School Rd to R High Choke left @ fork immediately on right #287

SUBDIVISION The Farms BLOCK / SECTION 5 LOT 617 LOT AREA 1.06 ac SITE CLASS. PS DESIGN FLOW 480 gpd L.T.A.R. e 3 inches/0.25 repair

Septic Tank: 1500 * Gallons; STB 338 Date 3-5-11

Pump Tank: 1000* Gallons; PT 27 Date 3-21-11

Pump Make Geotech Model WE0512HHD

Nitrification Field: No Fields 1 Square Feet 1200 Linear Feet 400

No Lines 4 Trench Width 36 Max Trench Bottom Depth 36" Gravel Depth NA ☐ Gravity ☒ Pressure

☒ New System ☐ Repair ☐ Expansion System Type: I II III IV V VI

System Description: pm 25% reduction accepted

Repair System Description: LPP PPDS

Maintenance Agreement Required: ☐ Yes ☒ No

☒ House/Mod. Home No. Bedrooms 4

☐ Mobile Home No. Persons ____

☐ Business No. Employees ____

☐ Other ____

Water Supply: ☐ Individual ☒ Public ☒ Community

☐ Slab ☒ Crawl Space ☐ Basement w/plumbing ☐ Basement wo/plumbing

Comments/Conditions: * Per Plan Specs.

Line lengths 105', 100', 100' & 95'

7/29/11 Tanks checked

Comments/Conditions: 7/29/11 Installed ADS 36 Plastic Chambers installed essentially as Drawn.

* Supply line around front of house >30" under drive.

Maint agreement w/ Stanley Septic

INITIAL SITE SKETCH

SEE PLAN from S&ME

AS BUILT SKETCH

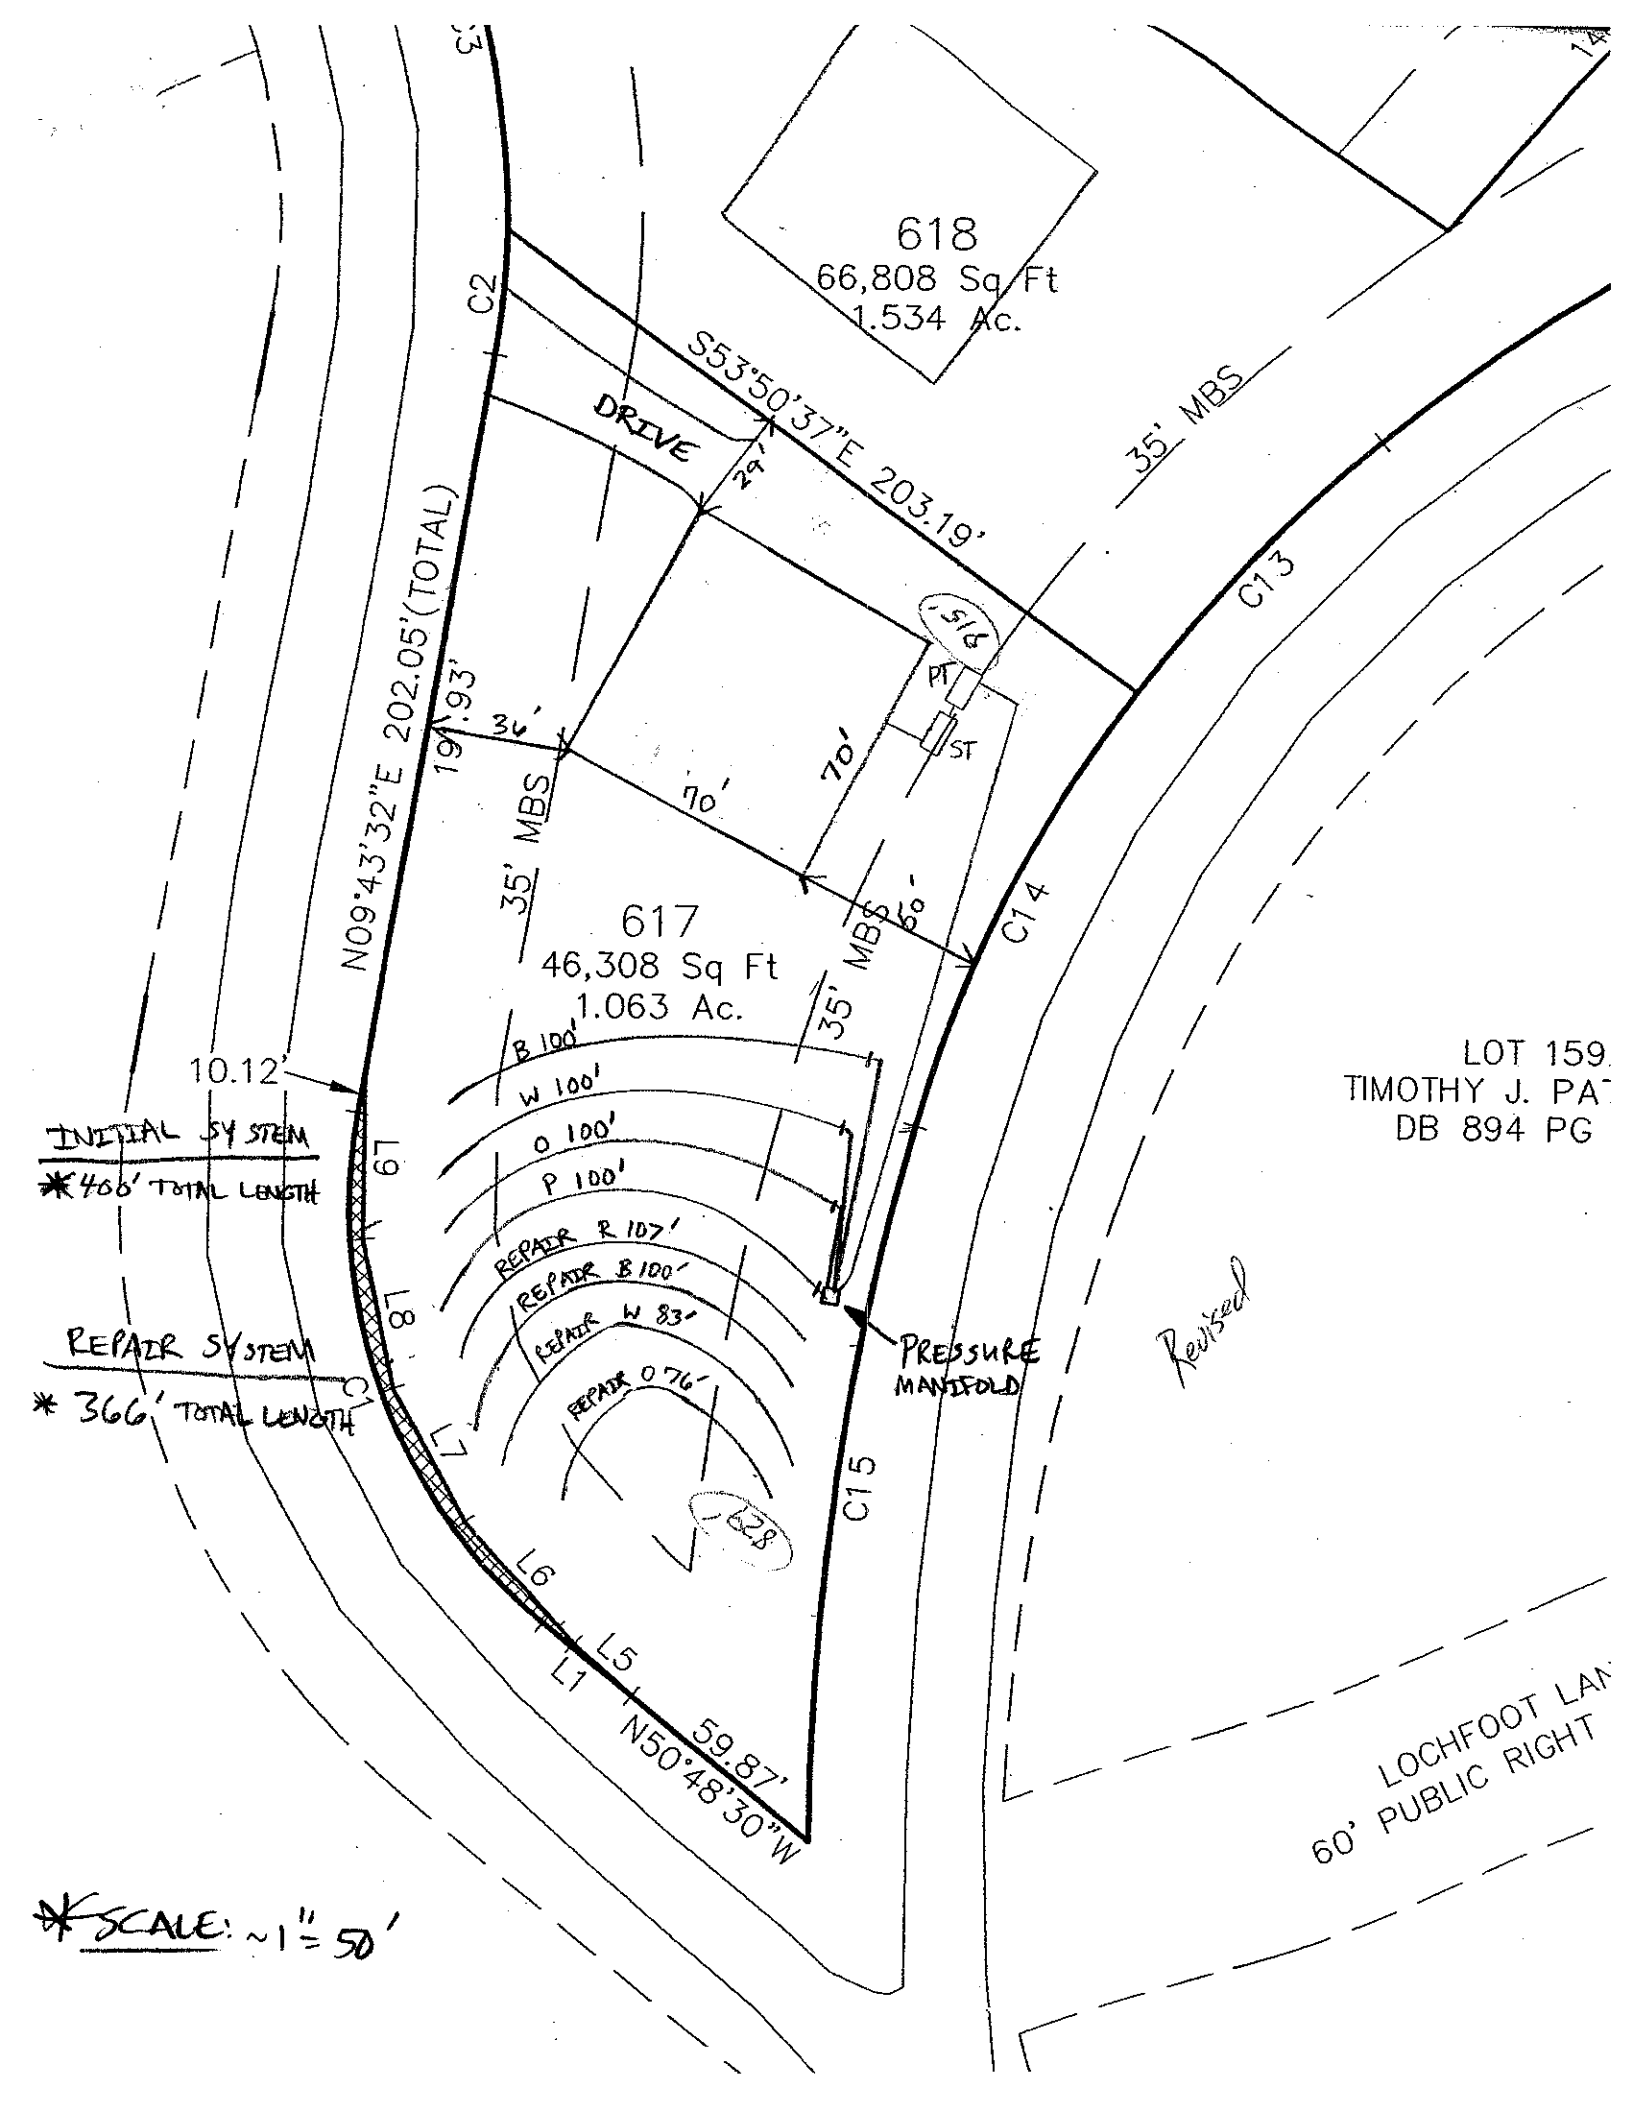
Permit can be suspended or revoked if any false information is supplied toward securing the permit/any unauthorized changes are made to the site/any unauthorized changes are made in the installation of the system. Improvement Permit with plat valid without expiration ☐ Improvement Permit with site plan valid for sixty months ☒ Authorization to Construct is valid for a period equal to that of Improvement Permit – not to exceed sixty months.

Signed: _____ date 4-30-07 Installed by: Richard Abernathy RS

Improvement Permit by: _____ date 3-8-07 Operation Permit by: _____ date 11/2/2011

Authorization to Construct by: _____ date 7-11-11 Existing System Inspection by: _____ date _____

HEALTH DEPT. COPY: WHITE OWNER COPY (FINAL): YELLOW OWNER COPY (INITIAL): PINK


618
66,808 Sq Ft
1.534 Ac.
617
46,308 Sq Ft
1.063 Ac.
DRIVE
29'
S53°50'37"E 203.19'
35' MBS
C13
C14
C15
C2
N09°43'32"E 202.05'(TOTAL)
194.93'
36'
35' MBS
110'
70'
60'
35' MBS
915'
PT
ST
628'
10.12'
INITIAL SYSTEM
*406' TOTAL LENGTH
REPAIR SYSTEM
* 366' TOTAL LENGTH
67
87
B 100'
W 100'
O 100'
P 100'
REPAIR R 107'
REPAIR B 100'
REPAIR W 83'
REPAIR O 76'
L1
L6
L5
L1
59.87'
N50°48'30"W
PRESSURE MANIFOLD
Revised
LOT 159
TIMOTHY J. PA
DB 894 PG
LOCHFOOT LA
60' PUBLIC RIGHT
*SCALE: ~1" = 50'