Site Address: 253 Digh Circle, Mrsvl.

2100

IREDELL COUNTY HEALTH DEPARTMENT

STATESVILLE 704-878-5305 MOORESVILLE 704-664-5281

IMPROVEMENT PERMIT / AUTHORIZATION TO CONSTRUCT / OPERATION PERMIT / EXISTING SYSTEM INSPECTION

PERMIT# 140026 PIN# 4627 40 ~~4946.62~~ 5932 DATE March 9, 2007

OWNER OR APPLICANT The Farms, LLC / Craig Carter PHONE: Business _____ Home _____

ADDRESS 2714 Brawley School Rd Mooresville, N.C. 28117

LOCATION Brawley School Rd TR McKendree TR Digh Left @ fork on Right

SUBDIVISION The Farms BLOCK / SECTION 5 LOT 621 LOT AREA 1.4 Ac SITE CLASS PS DESIGN FLOW 480 gpd L.T.A.R. .3

Septic Tank: 1500 * Gallons: STB 283 Date 2-27-14

Pump Tank: 1500 * Gallons: PT 326 Date 7-17-14

Pump Make Gould's Model WE0312 1/3HP Serial No. _____

Nitrification Field: No Fields 1 Square Feet 1200 Linear Feet 400

No Lines 5 Trench Width 36" Max Trench Bottom Depth 36" Gravel Depth N/A ☐ Gravity ☒ Pressure

☒ New System ☐ Repair ☐ Expansion System Type: I II III IV V VI

System Description: pm 25% Reduction accepted

Repair System Description: 25% Reduction

Maintenance Agreement Required: ☐ Yes ☒ No

☒ House/Mod. Home ☐ Mobile Home ☐ Business ☐ Other

No. Bedrooms 4 No. Persons ____ No. Employees ____

Water Supply: ☐ Individual ☒ Public ☒ Community

☐ Slab ☒ Crawl Space ☐ Basement w/plumbing ☐ Basement wo/plumbing

Comments/Conditions: * per plan specs

Comments/Conditions:

*Checked Lines & Tanks (ST+PT) ALP 4-25-14

6/9/14 Checked pressure, elect & alarm

INITIAL SITE SKETCH

OK TO Po 1000 GAL PT

3A

SEE PLAN from SAME

AS BUILT SKETCH

	Date	Initials
Drain Lines Checked	4-25-14	ALP
Tanks Checked	4-25-14	ALP
Pressure Manifold or Valve Box Checked	6/9/14	MR
Pressure Head Set	6/9/14	MR
Electrical Checked		
Floats Set		
Alarm Checked		
Maintenance Contract Y / N		

Permit can be suspended or revoked if any false information is supplied toward securing the permit/any unauthorized changes are made to the site/any unauthorized changes are made in the installation of the system. Improvement Permit with plat valid without expiration ☐ Improvement Permit with site plan valid for sixty months ☒ Authorization to Construct is valid for a period equal to that of Improvement Permit – not to exceed sixty months.

Signed: _____ date 4-30-07

Improvement Permit by: _____ date 3-9-07

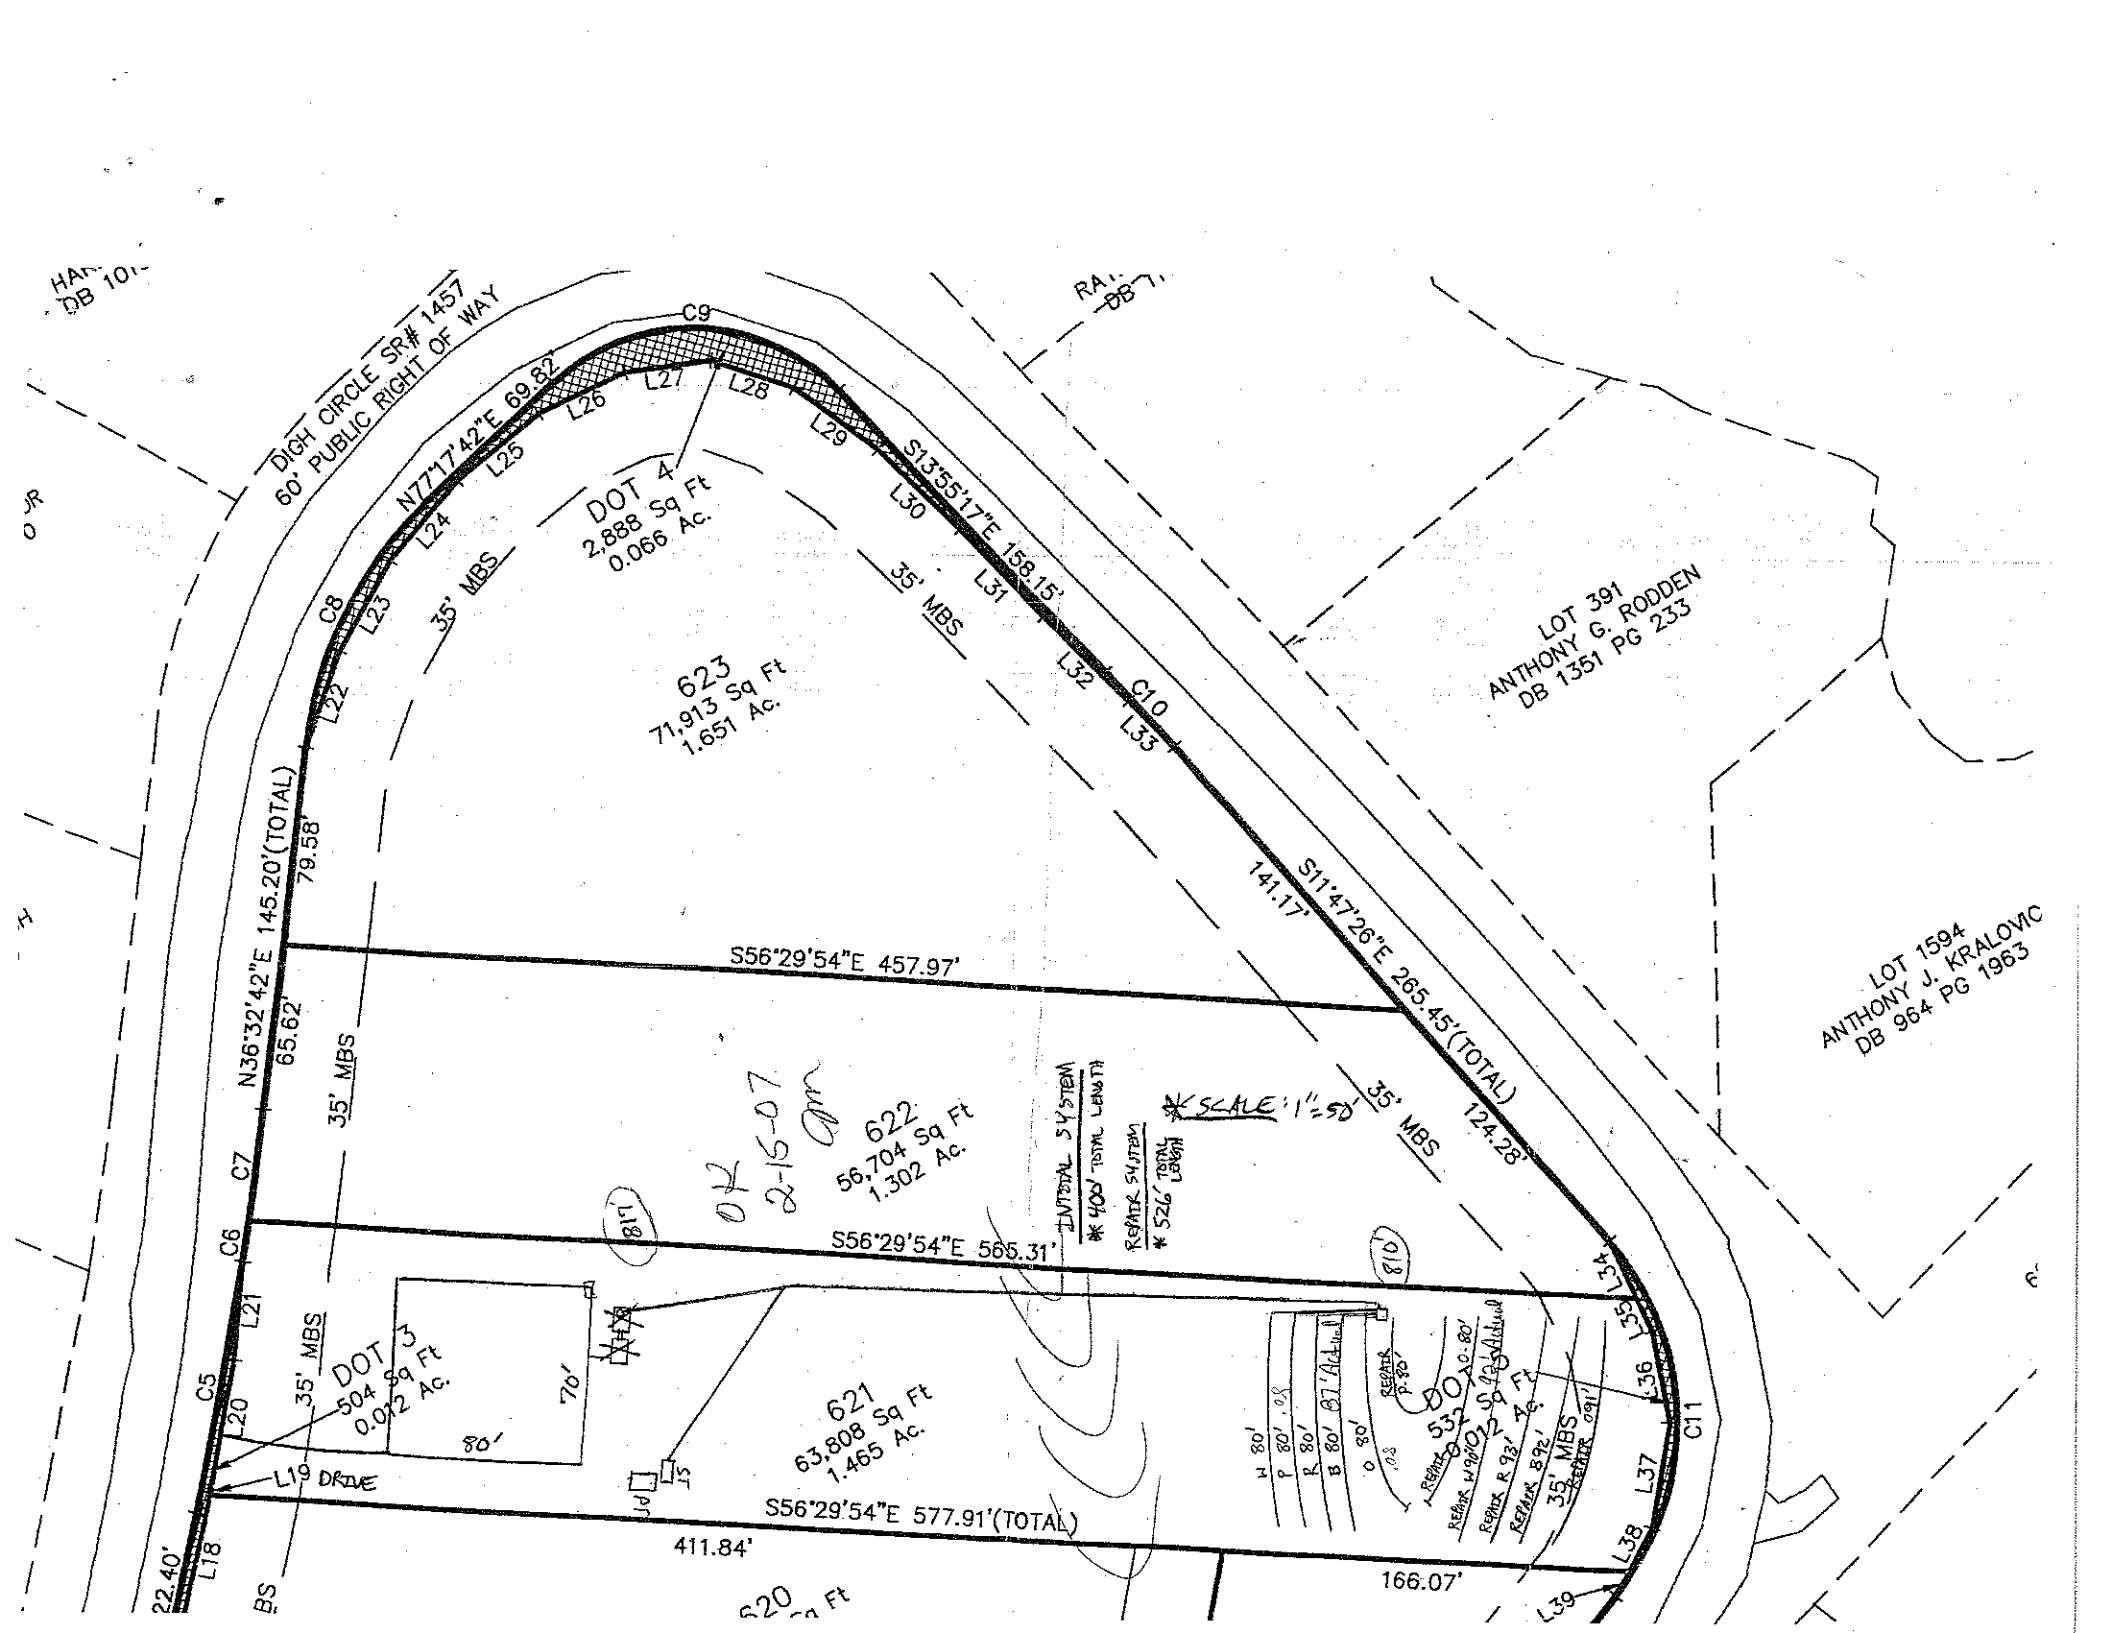
Authorization to Construct by: _____ date 7-15-09

Installed by: Richard H Abernathy RS

Operation Permit by: _____ date 6/9/14

Existing System Inspection by: _____ date _____

HEALTH DEPT. COPY: WHITE OWNER COPY (FINAL): YELLOW OWNER COPY (INITIAL): PINK


DIGH CIRCLE SR# 1457
60' PUBLIC RIGHT OF WAY
N77°17'42"E 69.82'
S13°55'17"E 158.15'
S11°47'26"E 265.45'(TOTAL)
124.28'
141.17'
N36°32'42"E 145.20'(TOTAL)
79.58'
65.62'
S56°29'54"E 457.97'
S56°29'54"E 565.31'
S56°29'54"E 577.91'(TOTAL)
411.84'
166.07'
22.40'
DOT 4
2,888 Sq Ft
0.066 Ac.
623
71,913 Sq Ft
1.651 Ac.
622
56,704 Sq Ft
1.302 Ac.
621
63,808 Sq Ft
1.465 Ac.
DOT 3
504 Sq Ft
0.012 Ac.
DOT 2
532 Sq Ft
0.012 Ac.
620
LOT 391
ANTHONY G. RODDEN
DB 1351 PG 233
LOT 1594
ANTHONY J. KRALOVIC
DB 964 PG 1963
35' MBS
L19 DRIVE
80'
70'
810'
* SCALE: 1" = 50'
02
2-15-07