IREDELL COUNTY HEALTH DEPARTMENT

STATESVILLE 704-878-5305 MOORESVILLE 704-664-5281

IMPROVEMENT PERMIT / CERTIFICATE OF COMPLETION / OPERATION PERMIT / EXISTING SYSTEM INSPECTION

PROPERTY DESCRIPTION NO. 22497 DATE April 26, '96 TAX MAP NO. part of 2LA11 / 4627-40-6100 Watershed: ☑ Yes ☐ No

OWNER OR CONTRACTOR Epster Dev. Corp. PHONE: Business Home

ADDRESS 227 Hideaway Lane, Mooresville

LOCATION Brawley Sch Rd. / TR McKendree TR High Circle TR Lockfoot Lane on Right

SUBDIVISION Hawks Nest BLOCK / SECTION LOT 1 LOT AREA .86 ac SITE CLASS. PS per 1996 DESIGN FLOW 360 gpd L.T.A.R. .3

Septic Tank: 1000 Gallons; STB 1012 Date 4/17/98

Pump Tank: Gallons; PT Date

Pump Make: Model Serial No.

Nitrification Field: No Fields 1 Square Feet 1200 Linear Feet 400

No Lines 4@100' Trench Width 36" Max Trench Bottom Depth 36" Gravel Depth 12"

☑ New System ☐ Repair System Type: I II III IV V VI

System Description: gravity conventional

Repair System Description: gravity chambered

Maintenance Agreement Required ☐ Yes ☑ No

☑ House/Mod. Home No. Bedrooms 3

☐ Mobile Home No. Bathrooms 2½

☐ Business No. Employees

☐ Other


☐ Slab ☑ Crawl Space ☐ Basement w/plumbing ☐ Basement wo/plumbing

Water Supply: ☑ Individual ☐ Community ☐ Public

Comments:

Comments:

INITIAL SITE SKETCH NOT TO SCALE

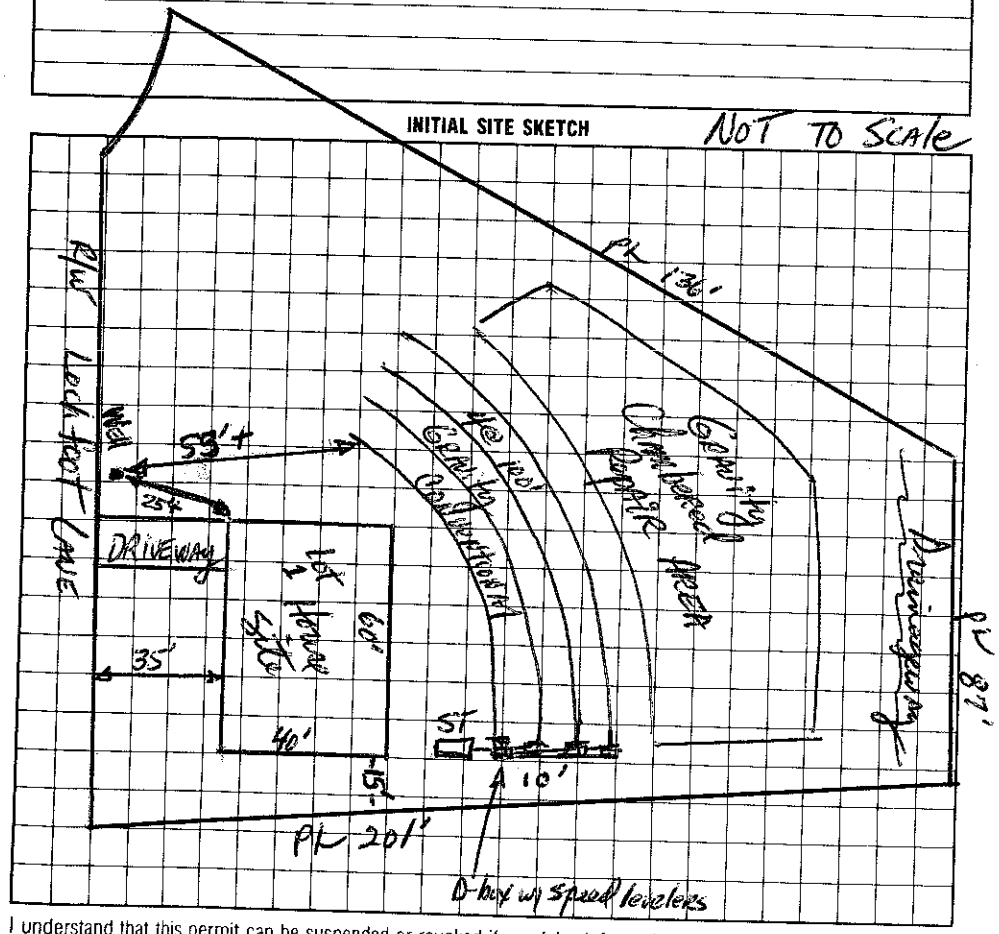

AS BUILT SKETCH

I understand that this permit can be suspended or revoked if any false information is supplied toward securing the permit/any unauthorized changes are made to the site/any unauthorized changes are made in the installation of the system.

Signed:

Improvement Permit by: date 4-26-96

Existing System Inspection by: date 12-3-96

Installed by: Tommy Caughran

Certificate of Completion by: Wesley Sparks RS date 6/15/98

Operation Permit by: Wesley Sparks RS date 6/19/98

HEALTH DEPT. COPY: WHITE INSPECTION COPY (FINAL): GREEN OWNER COPY (FINAL): YELLOW INSPECTION COPY (INITIAL): PINK OWNER COPY (INITIAL): GOLD