IREDELL COUNTY HEALTH DEPARTMENT

STATESVILLE 704-878-5305 MOORESVILLE 704-664-5281

IMPROVEMENT PERMIT / AUTHORIZATION TO CONSTRUCT / OPERATION PERMIT / EXISTING SYSTEM INSPECTION

PERMIT# Repair PIN# 4627408230 DATE 12/13/02

OWNER OR CONTRACTOR Kevin Scruggs PHONE: Business Home 704-664-5451

ADDRESS 126 Lochfoot Ln. Mooresville NC 28117

LOCATION Brawley sch, TR McKendree, TR Dish, TR Lochfoot at end

SUBDIVISION CL+T BLOCK / SECTION 5 LOT 400 LOT AREA 0.82 Ac. SITE CLASS PS DESIGN FLOW 480 L.T.A.R.

Septic Tank: Existing Gallons; STB Date

Pump Tank: Gallons; PT Date

Pump Make: Model Serial No.

Nitrification Field: No Fields Square Feet 900 Linear Feet 75'

No Lines Trench Width 12' Max Trench Bottom Depth 36" Gravel Depth 4 ~~6~~"

☐ New System ☒ Repair System Type: I II III IV V VI

System Description:

Repair System Description: Gravel Bed

Maintenance Agreement Required: ☐ Yes ☒ No

☒ House/Mod. Home No. Bedrooms 4

☐ Mobile Home No. Bathrooms 3

☐ Business No. Employees

☐ Other


☐ Slab ☐ Crawl Space ☒ Basement w/plumbing ☐ Basement wo/plumbing

Water Supply: ☒ Individual ☐ Public ☐ Community Exist.


Comments:/Conditions: Existing System - Kevin Scruggs 1988

Comments:/Conditions:

INITIAL SITE SKETCH

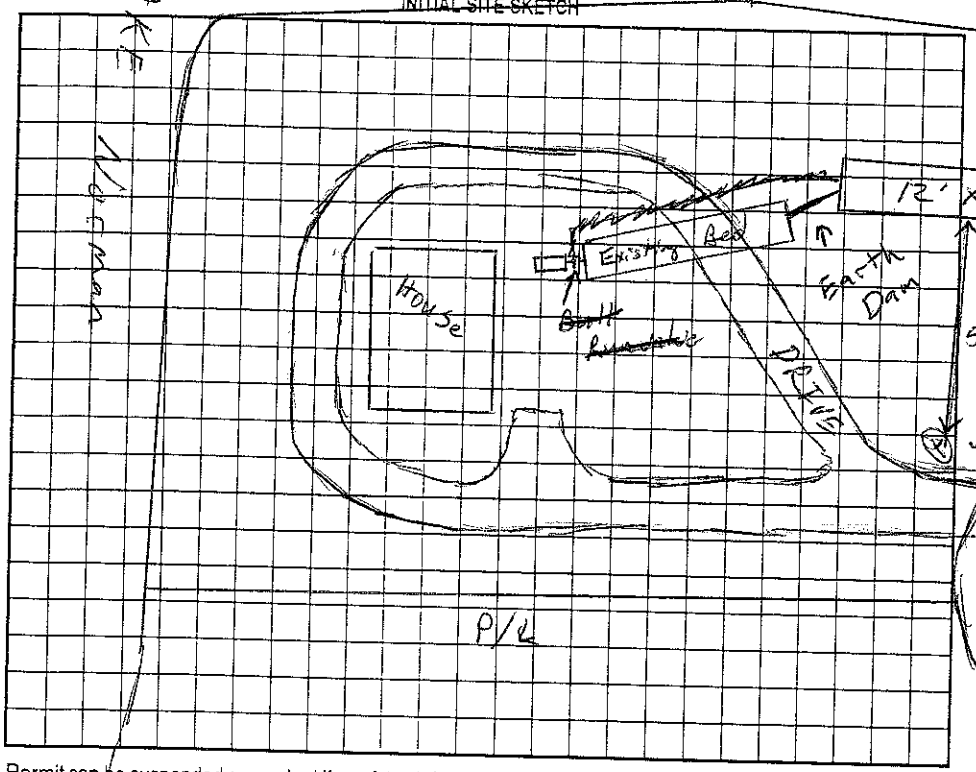

AS BUILT SKETCH

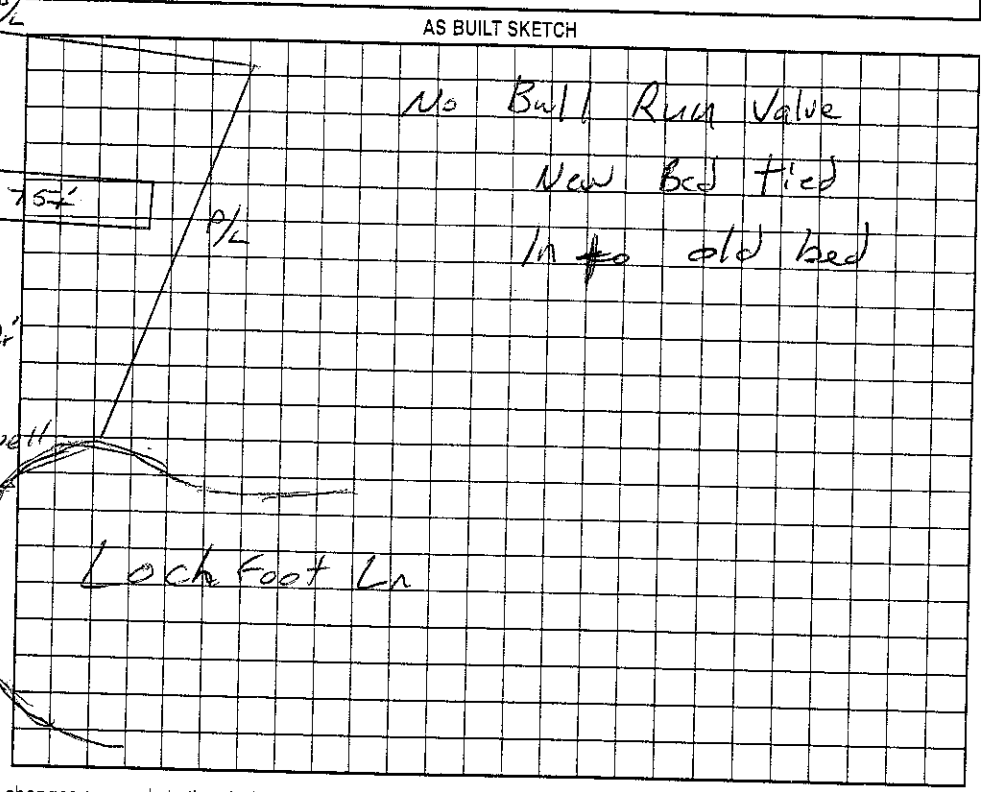

Permit can be suspended or revoked if any false information is supplied toward securing the permit/any unauthorized changes are made to the site/any unauthorized changes are made in the installation of the system. Improvement Permit with plat valid without expiration. Improvement Permit with site plan valid for sixty months. Authorization to Construct is valid for a period equal to that of Improvement Permit – not to exceed sixty months.

Signed: date

Improvement Permit by: RS date 12/13/02

Authorization to Construct by: RS date 12/13/02

Installed by: Abernathy

Operation Permit by: RS date 12/14/02

Existing System Inspection by: date

HEALTH DEPT. COPY: WHITE OWNER COPY (FINAL): YELLOW OWNER COPY (INITIAL): PINK