IREDELL COUNTY HEALTH DEPARTMENT

STATESVILLE 704-878-5305 X MOORESVILLE 704-664-5281

IMPROVEMENT PERMIT / AUTHORIZATION TO CONSTRUCT / OPERATION PERMIT / EXISTING SYSTEM INSPECTION

PERMIT # 140029 PIN # 4627404796.622 DATE 11-29-2012

OWNER or APPLICANT Tom Palmer Homes Inc PHONE: Business 980 241 9693 Home: 704 780-1448

OWNER or APPLICANT ADDRESS P.O. Box 2387 Davidson, NC

LOCATION / DIRECTIONS Brawley School Rd TR McKendree TR Digh Circle on left. 247 Digh Circle

SUBDIVISION The Farms BLOCK / SECTION 5 LOT # 622 LOT AREA 1.30 DESIGN FLOW 480 gpd L.T.A.R. .3

Septic Tank 1000/1500 Gallons: STB 338 Date 4-6-13

Pump Tank 1000 Gallons: PT 27 Date 4-7-13

Pump Make GOULDS Model WE05512HH Serial #

Nitrification Field No Fields 1 No Lines 6 Linear Feet 400'

Trench Width 36" Max. Trench Bottom Depth 36" Gravel Depth N/A

☒ New System ☐ Repair ☐ Expansion System Type I II (III) IV V VI

System Description: Pump-PM-25% Reduction

Repair System Description: Pump-LP-PPBPS

Maintenance Agreement Required ☐ YES ☒ NO Not Initially

☐ GRAVITY ☒ PRESSURE

☒ Residence No. Bedrooms 4

☐ Business No. Persons

☐ Other No. Employees

☐ Slab ☒ Crawl Space

☐ Basement w/plumbing ☐ Basement w/o plumbing

Water Supply: ☐ Private ☒ Public ☒ Community

Comments / Conditions: Note: Shave off old berms. Original Field/Soil Work performed by SAME. Initial System needs to be installed above Old Road Bed. *


Comments / Conditions: This permit replaces previous permit dated 3-20-07 * Note: Must do "cased entry" for Bonus Room

4m


#212 Digh Circle

(Drainfield area across fro

INITIAL SITE SKETCH

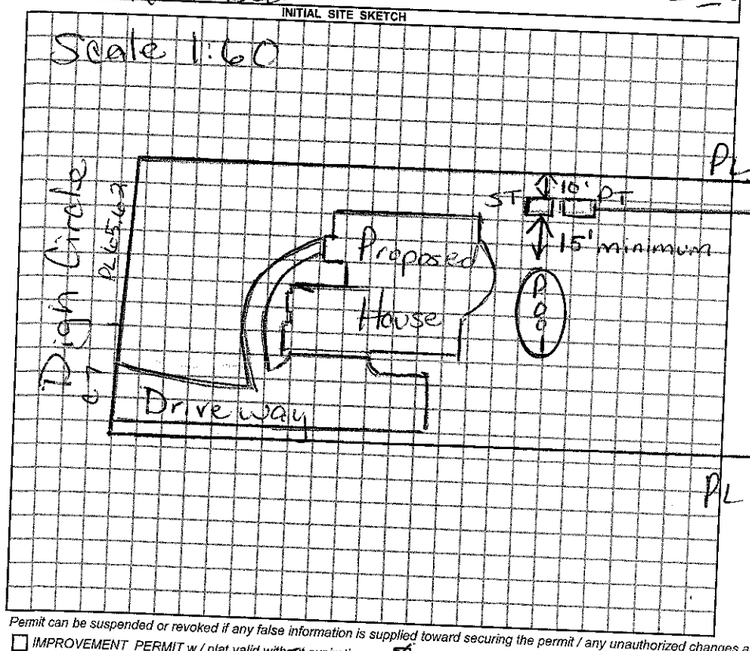

AS BUILT SKETCH

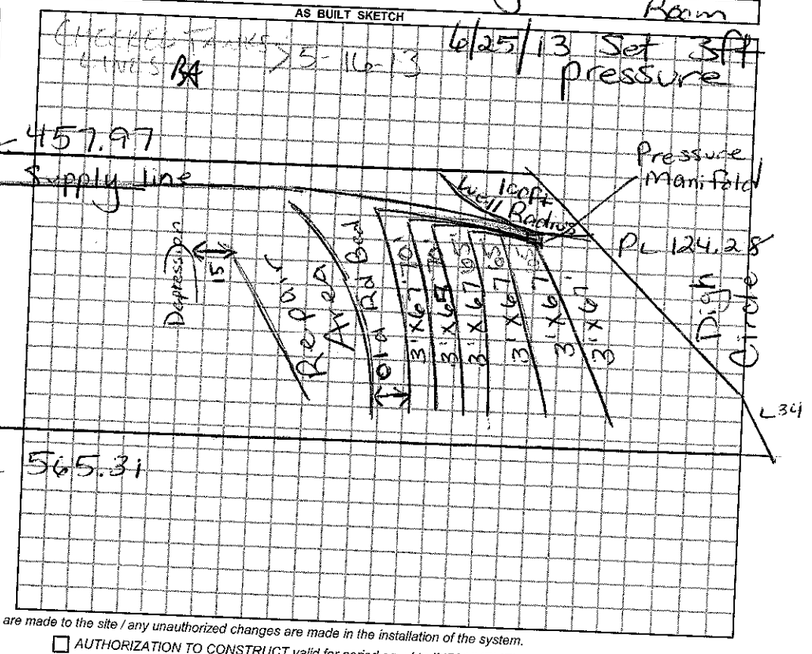

Permit can be suspended or revoked if any false information is supplied toward securing the permit / any unauthorized changes are made to the site / any unauthorized changes are made in the installation of the system.

☐ *IMPROVEMENT PERMIT w / plat valid without expiration.* ☒ *IMPROVEMENT PERMIT w / site plan valid for 60 mos.*

☐ *AUTHORIZATION TO CONSTRUCT valid for period equal to IMPROVEMENT PERMIT-not to exceed 60 mo.*

Owner / Applicant Signature: Date 12/7/12

Improvement Permit by: Date 11/29/12

Authorization to Construct by: Date 11/29/12

YOU SHOULD CONTACT A LOCATOR SERVICE PRIOR TO ANY EXCAVATION!

Installed by: HAUMAN

Operation Permit by: Date: 6/26/13

Existing System Inspected by: Date:

WHITE COPY Environmental Health YELLOW COPY (Final) Owner / Applicant PINK COPY (Initial) Owner / Applicant