IREDELL COUNTY HEALTH DEPARTMENT

STATESVILLE 704-878-5305 MOORESVILLE 704-664-5281

IMPROVEMENT PERMIT / CERTIFICATE OF COMPLETION / OPERATION PERMIT / EXISTING SYSTEM INSPECT.

PROPERTY DESCRIPTION NO. 18565 DATE Oct. 6, '95 TAX MAP NO. 2L2A391 Watershed: ☑ Yes ☐ ...

OWNER OR CONTRACTOR Anthony G. Rodden PHONE: Business 4627419022 Home 663-6507

ADDRESS 212 Dish Circle Mooresville

LOCATION Brawley Sch. Rd TR McKendree, TR Dish Circle ~½ mile on Right

SUBDIVISION Crescent LN BLOCK / SECTION 8 LOT 391 LOT AREA ~3/4 Ac SITE CLASS. PS pre 1956 DESIGN FLOW 480gpd L.T.A.R. .3

Septic Tank: 1000 + Gallons; STB ____ Date ____

Pump Tank: ____ Gallons; PT ____ Date ____

Pump Make: ____ Model ____ Serial No. ____

Nitrification Field: No Fields 1+2 Square Feet ____ Linear Feet 135'

No Lines 3@45' Trench Width 24" Max Trench Bottom Depth 36" Gravel Depth N/A

☐ New System ☑ Repair System Type: I, II, III, IV, V, VI

System Description: Existing & Gravity Panel

Repair System Description: GRAV. PPBPS & CPPPBPS

Maintenance Agreement Required: ☐ Yes ☑ No

☑ House/Mod. Home No. Bedrooms 4

☐ Mobile Home No. Bathrooms 3

☐ Business No. Employees ____

☐ Other ____


☐ Slab ☐ Crawl Space ☑ Basement w/plumbing ☐ Basement wo/plumbing

Water Supply: ☑ Individual ☐ Community ☐ Public

Comments: Upgrading 2 bedroom drainfield to 4 bedroom capacity
Setting new tank due to old tank being in basement area.

Comments:

INITIAL SITE SKETCH

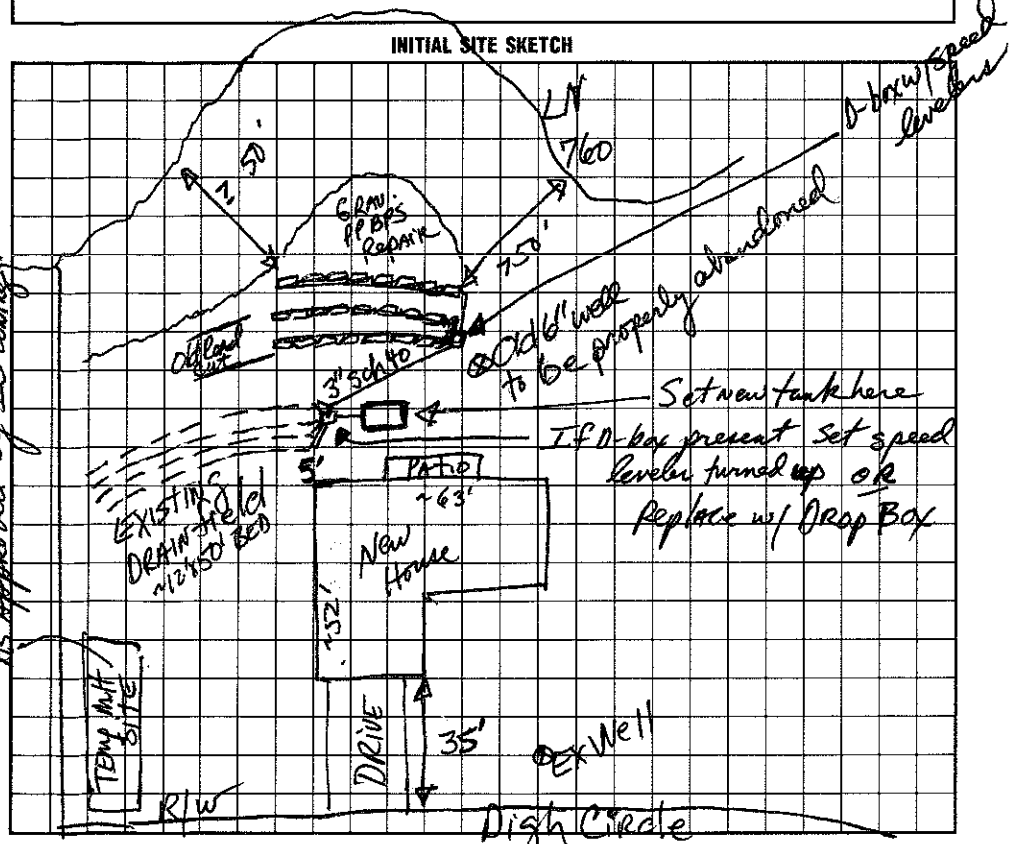

AS BUILT SKETCH

I understand that this permit can be suspended or revoked if any false information is supplied toward securing the permit/any unauthorized changes are made to the site/any unauthorized changes are made in the installation of the system.

Signed: Anthony G. Rodden

Improvement Permit by: ____ date 10/6/95

Existing System Inspection by: Auth to Construct ____ date 10/6/95

Installed by: Tim Cummons

Certificate of Completion by: ____ date ____

Operation Permit by: Wesley Sparks RS date 8/30/96

HEALTH DEPT. COPY: WHITE INSPECTION COPY (FINAL): GREEN OWNER COPY (FINAL): YELLOW INSPECTION COPY (INITIAL): PINK OWNER COPY (INITIAL): GOLD