* THIS PERMIT REPLACES EXPIRED PERMIT DATED 12/12/98 *

IREDELL COUNTY HEALTH DEPARTMENT

STATESVILLE 704-878-5305 55000 MOORESVILLE 704-664-5281

IMPROVEMENT PERMIT / AUTHORIZATION TO CONSTRUCT / OPERATION PERMIT / EXISTING SYSTEM INSPECTION

PERMIT# 132278 PIN# 4627 49 8601 DATE 11/29/05

OWNER OR APPLICANT Jim BRANNER (SPEC CONSTRUCTION) PHONE: Business 828 757 3861 Home

ADDRESS PO Box 173 COLLETTSVILLE, NC 28611

LOCATION 150 W (L) HIGH ~~LANDS~~ HILLS DR LOT AT END ON CUL-DE-SAC 166 HIGH HILLS DR

SUBDIVISION PINNACLE ~~SHORES~~ HILLS BLOCK / SECTION 4 LOT 27+27A LOT AREA .8 ACRES SITE CLASS. PS DESIGN FLOW 480 gpd L.T.A.R. .25

Septic Tank: 1000 Gallons; STB 160 Date 11/16/05
Pump Tank: 1000 Gallons; PT 319 Date 5/06
Pump Make: ZOELLER Model N-191-0008 Serial No.
Nitrification Field: No Fields 1 Square Feet EQ 1920 Linear Feet 480
No Lines 4 Trench Width 36" ~~Max~~ Trench Bottom Depth 36"

☒ New System ☐ Repair ☐ Expansion System Type: I II (III) IV V VI
System Description: 25% REDUCTION
Repair System Description: LP PANEL
Maintenance Agreement Required: ☐ Yes ☒ No

☒ House/Mod. Home ☐ Mobile Home ☐ Business ☐ Other
No. Bedrooms 4 No. Persons No. Employees

Water Supply: ☐ Individual ☒ Public ☐ Community


Gravel Depth NA ☐ Gravity ☒ Pressure ☐ Slab ☐ Crawl Space ☒ Basement w/plumbing ☐ Basement wo/plumbing

Comments:/Conditions: INSTALL ON CONTOUR. MAINTAIN SETBACKS. INSTALL LINES A minimum OF 36" DEEP. INSTALL ONE INSPECTION PORT PER LINE.


Scale: 1" = 100'

Comments:/Conditions:

INITIAL SITE SKETCH

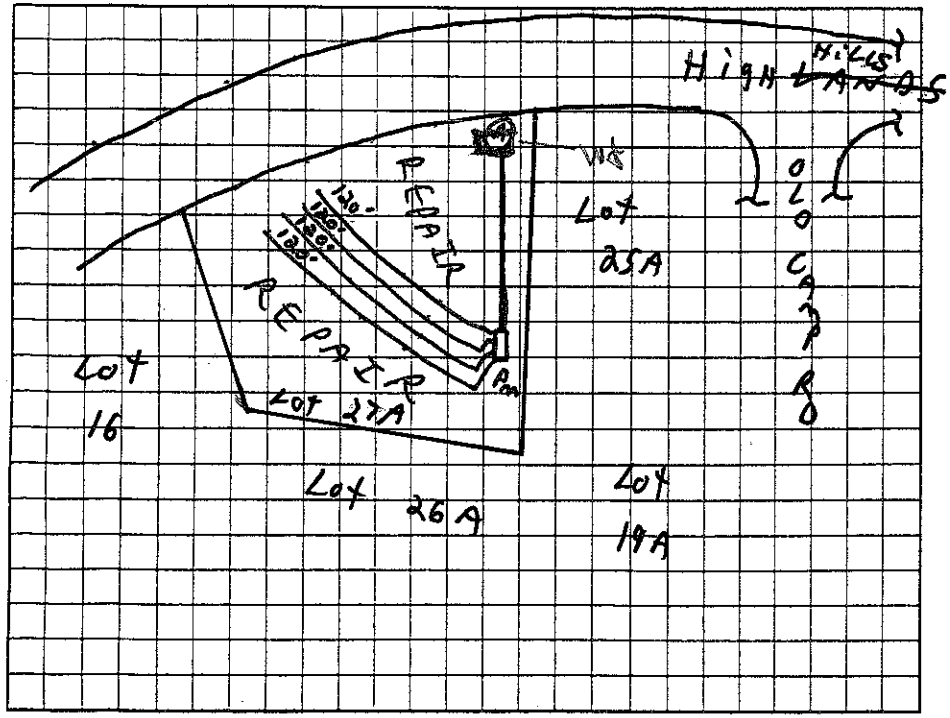

AS BUILT SKETCH

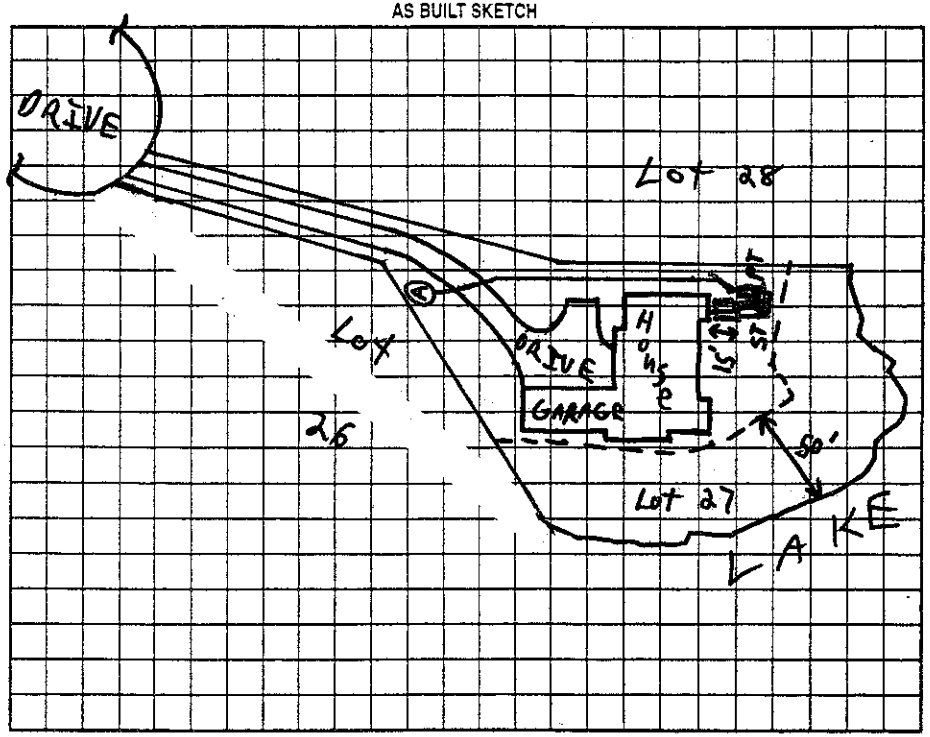

Permit can be suspended or revoked if any false information is supplied toward securing the permit/any unauthorized changes are made to the site/any unauthorized changes are made in the installation of the system. Improvement Permit with plat valid without expiration ☐ Improvement Permit with site plan valid for sixty months ☒ Authorization to Construct is valid for a period equal to that of Improvement Permit – not to exceed sixty months.

Signed: Edward K. [illegible] date 11-30-05 Installed by: Bob Brannon

Improvement Permit by: [signature] date 11/29/05 Operation Permit by: Wesley Sparks RS date 9/18/06

Authorization to Construct by: [signature] date 11/29/05 Existing System Inspection by: date

HEALTH DEPT. COPY: WHITE OWNER COPY (FINAL): YELLOW OWNER COPY (INITIAL): PINK