125

IREDELL COUNTY HEALTH DEPARTMENT

STATESVILLE 704-878-5305 MOORESVILLE 704-664-5281

IMPROVEMENT PERMIT / AUTHORIZATION TO CONSTRUCT / OPERATION PERMIT / EXISTING SYSTEM INSPECTION

PERMIT# 075669 PIN# 4726889970 (pt) 4627 49 8840 DATE Dec 12, '98

OWNER OR CONTRACTOR Crescent Resources Mgmt. PHONE: Business Home

ADDRESS PO Box 1033, Charlotte

LOCATION 150W on TL Highlands Drive, on Right

SUBDIVISION Pinnacle Shores BLOCK / SECTION 4 LOT 26, 26A LOT AREA 25,261 sf+ SITE CLASS. RS DESIGN FLOW 480 gpd L.T.A.R. 0.3

Septic Tank: 1500 Gallons; STB 312 Date 10/8/99
Pump Tank: 1000 Gallons; PT 27 Date 10/8/99
Pump Make: MYERS Model ME-100 S2 Serial No. 7/99
Nitrification Field: No Fields 1 Square Feet 1200 Linear Feet 400
No Lines 4@100' Trench Width 36" Min. Trench Bottom Depth 36"

☑ New System ☐ Repair System Type: I, II, III, IV, V, VI
System Description: Pumped-on-25% Red. Innovative
Repair System Description: LP Panel Block
Maintenance Agreement Required: ☐ Yes ☑ No initially
Gravel Depth N/A

☑ House/Mod. Home No. Bedrooms 4
☐ Mobile Home No. Bathrooms 4
☐ Business No. Employees
☐ Other
☐ Slab ☐ Crawl Space ☑ Basement w/plumbing ☐ Basement wo/plumbing


Water Supply: ☐ Individual ☑ Public ☑ Community

Comments:/Conditions: * ONE inspection port per lateral
Install trenches at 36" min. trench bottom depth.


Comments:/Conditions:

1"=100'

INITIAL SITE SKETCH

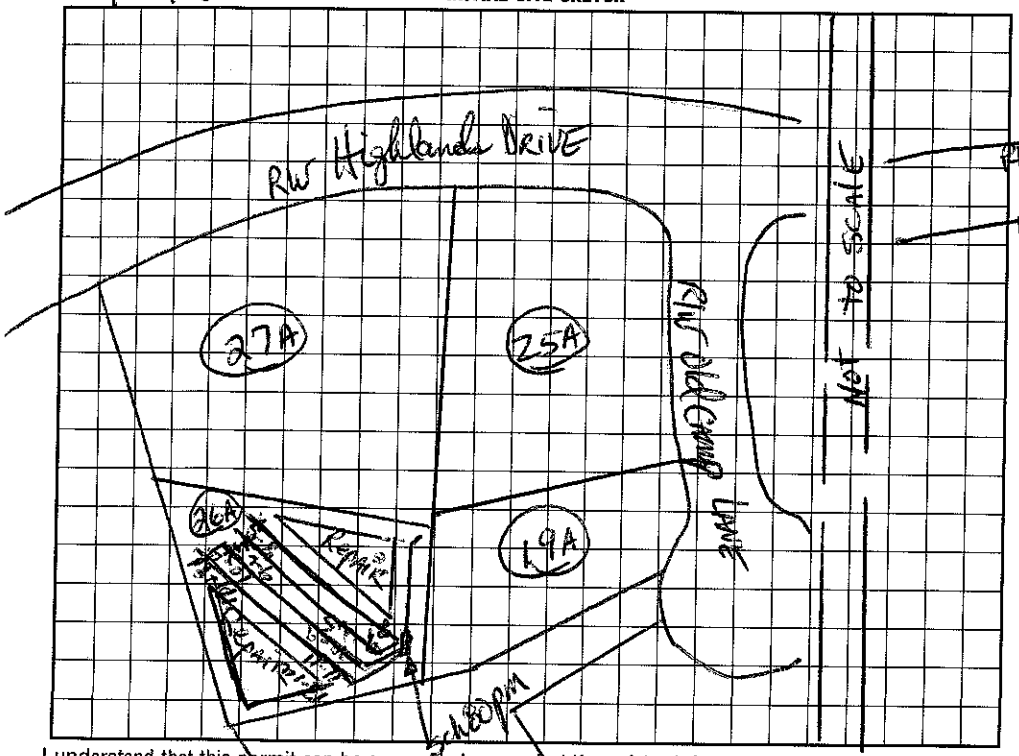

AS BUILT SKETCH

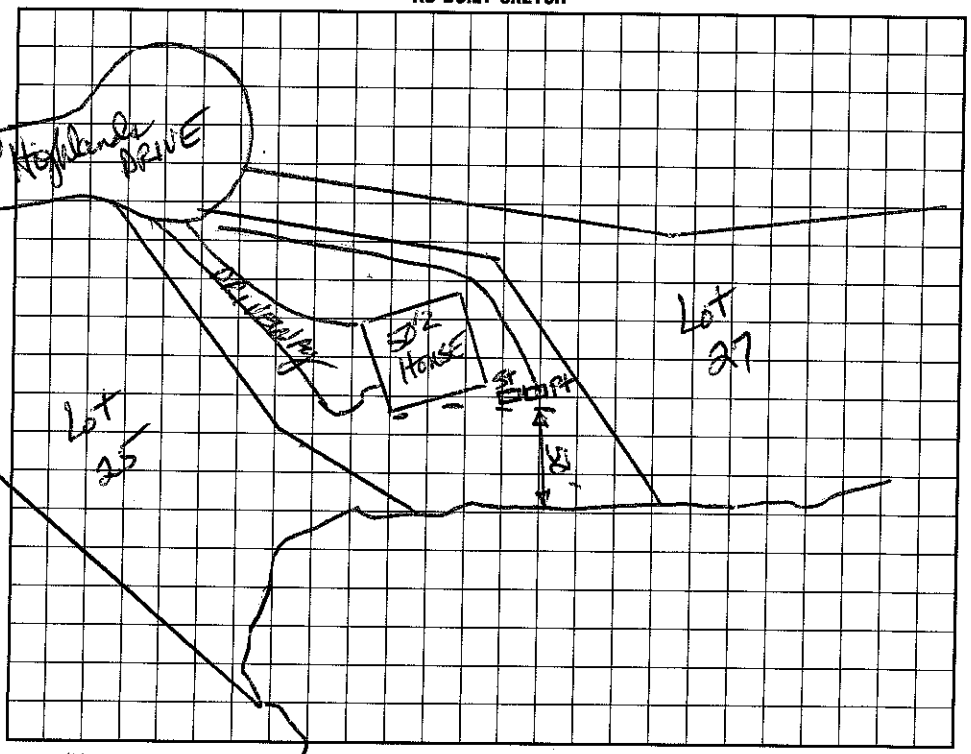

I understand that this permit can be suspended or revoked if any false information is supplied toward securing the permit/any unauthorized changes are made to the site/any unauthorized changes are made in the installation of the system. Improvement Permit with plat valid without expiration. Improvement Permit with site plan valid for sixty months. Authorization to Construct is valid for a period equal to that of Improvement Permit – not to exceed sixty months.

Signed: date 12/18/98 Installed by: Dobson Const.

Improvement Permit by: date 12-2-98 Operation Permit by: date 3/3/00

Authorization to Construct by: date 6/4/99 Existing System Inspection by: date

HEALTH DEPT. COPY: WHITE INSPECTION COPY (FINAL): GREEN OWNER COPY (FINAL): YELLOW INSPECTION COPY (INITIAL): PINK OWNER COPY (INITIAL): GOLD