IREDELL COUNTY HEALTH DEPARTMENT

STATESVILLE 704-878-5305 MOORESVILLE 704-664-5281

IMPROVEMENT PERMIT / AUTHORIZATION TO CONSTRUCT / OPERATION PERMIT / EXISTING SYSTEM INSPECTION

PERMIT# 075668 PIN# 4726869970 (pt) 4627 49 8966 DATE Dec 12, 1998

OWNER OR CONTRACTOR Crescent Resources Inc PHONE: Business Home

ADDRESS P.O. Box 1003, Charlotte

LOCATION 150 W ~~Highlands~~ DRIVE on Right HIGH HILLS LN. on (R) AT CAMP LN.

SUBDIVISION Peninsula Shores BLOCK / SECTION 4 LOT 25,25A LOT AREA 26,462 +/- SITE CLASS. PS DESIGN FLOW 480gpd L.T.A.R. 0.25

Septic Tank: 1000 Gallons; STB 312 Date 12/2/99

Pump Tank: 1000 Gallons; PT 27 Date 11/10/00

Pump Make: Model Serial No.

Nitrification Field: No Fields 1 Square Feet 1500 Linear Feet 500

No Lines 5 @ 100' Trench Width 36" Trench Bottom Depth 36"

☑ New System ☐ Repair System Type: I, II, III, IV, V, VI

System Description: pumped-pm-25% fcd/Innovative

Repair System Description: LP Panel Black

Maintenance Agreement Required: ☐ Yes ☑ No

Gravel Depth NA

☑ House/Mod. Home No. Bedrooms 4

☑ Mobile Home No. Bathrooms 4

☐ Business No. Employees

☑ Other


☐ Slab ☐ Crawl Space ☑ Basement w/plumbing ☐ Basement wo/plumbing

Water Supply: ☐ Individual ☑ Public ☐ Community


Comments/Conditions: Earth mound (EM) to be Removed from drainfield AREA. * ONE INSPECTION PORT PER LATERAL INSTALL LATERALS AT 36" min. trench bottom depth.

Comments:/Conditions: 7-22-99 Reviewed house & site plan - appears substantially in compliance w/ LP DRFT 2 Lay - installed.

INITIAL SITE SKETCH 1"=100'

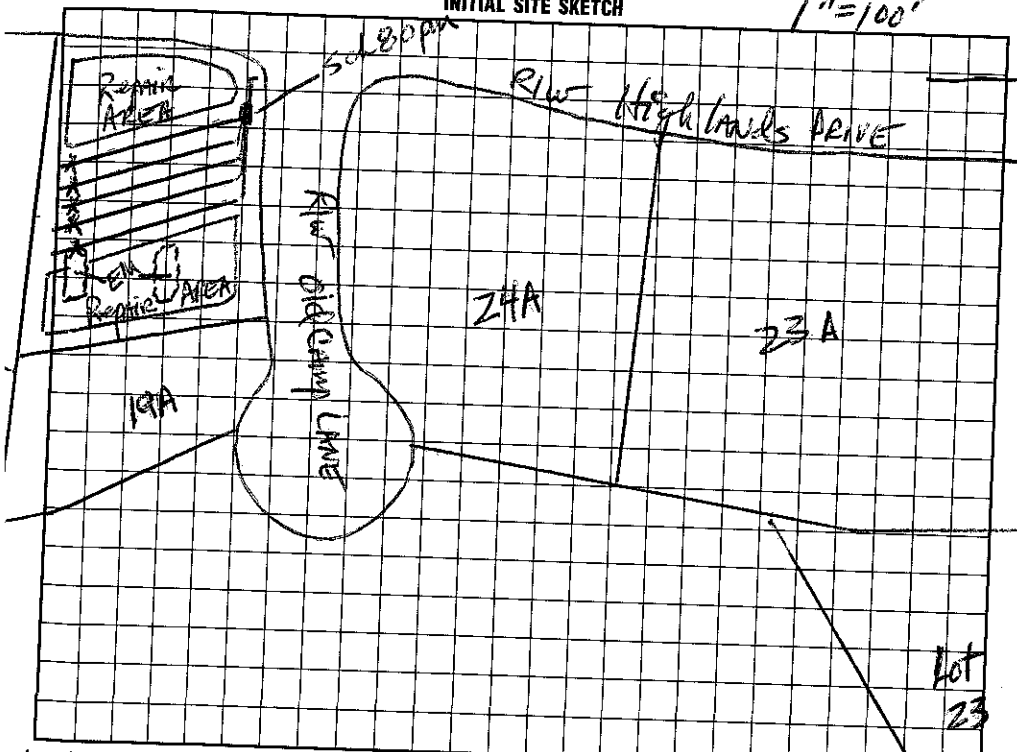

AS BUILT SKETCH 2/24/00 Checked Drainfield

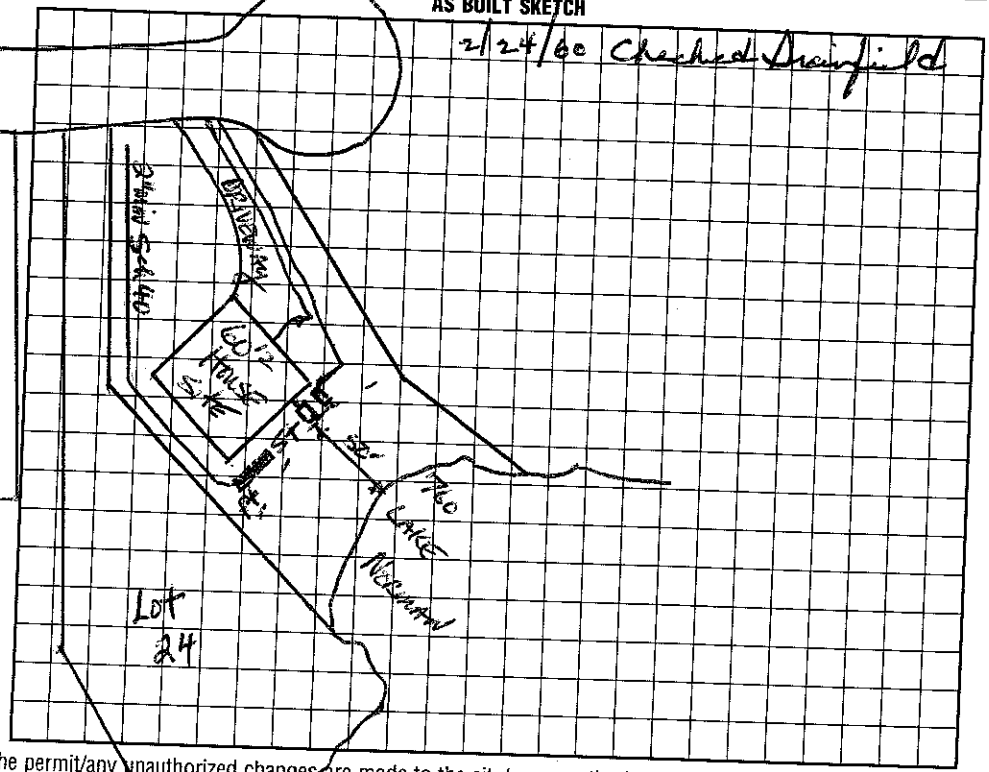

I understand that this permit can be suspended or revoked if any false information is supplied toward securing the permit/any unauthorized changes are made to the site/any unauthorized changes are made in the installation of the system. Improvement Permit with plat valid without expiration. Improvement Permit with site plan valid for sixty months. Authorization to Construct is valid for a period equal to that of Improvement Permit – not to exceed sixty months.

Signed:

Improvement Permit by: RS date 12/15/98

Authorization to Construct by: RS date 12-12-98

Installed by: Reade Eudy

Operation Permit by: RSI date 7/19/00

Existing System Inspection by: date

HEALTH DEPT. COPY: WHITE INSPECTION COPY (FINAL): GREEN OWNER COPY (FINAL): YELLOW INSPECTION COPY (INITIAL): PINK OWNER COPY (INITIAL): GOLD