IREDELL COUNTY HEALTH DEPARTMENT

Statesville Phone TR 3-7271 Mooresville Phone NO 3-1271

PERMIT TO INSTALL SEPTIC TANK

Permit No. 114 Permit Date 8-25-1971

Owner J. T. Stevens Address Charlotte

Installed By C&C construction Address 42 Box 35 c Minneapolis


Location of Property Sec 8 (342) → 404

Tank		Capacity		Length of Lines		Fixtures	
Block	( )	1000	( )	225'	( )	No. of Baths	(1)
Precast	(✓)	1250	( )	250'	( )	Dishwasher	( )
		1500	( )	Other 200		Garbage Grdr.	( )
		Other				Other	

NOTIFY HEALTH DEPARTMENT AT LEAST EIGHT HOURS BEFORE TANK IS TO BE INSPECTED.

Final Inspection 8-25-1971 Approved (✓) Disapproved ( )

Remarks 3ft. Ditch per Line

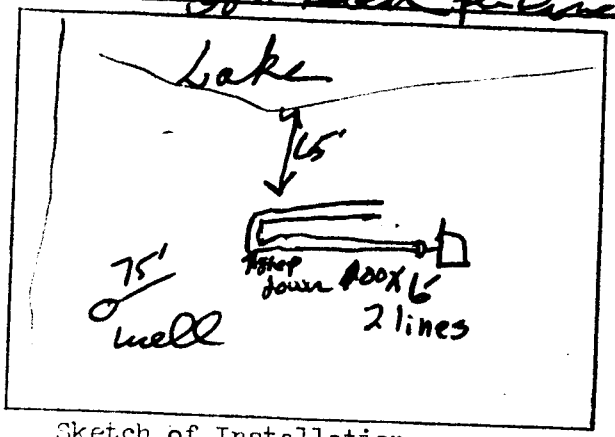

Sketch of Installation

J. C. Moore

Sanitarian