IREDELL COUNTY HEALTH DEPARTMENT

Authorization to Construct

4627 50 2089

STATESVILLE 704-878-5305 MOORESVILLE 704-664-5281

IMPROVEMENT PERMIT / ~~CERTIFICATE OF COMPLETION~~ / OPERATION PERMIT / EXISTING SYSTEM INSPECTION

PROPERTY DESCRIPTION NO. Repair DATE 1/3/96 TAX MAP NO. Watershed: X Yes ☐ No

OWNER OR CONTRACTOR Dr. Wm. Griffin c/o Allied Commercial PHONE: Business 662-8761 Home

ADDRESS PO Box 630 Mooresville, NC. 28115

LOCATION Montclair. - McLendon TR High Cir TR Montclair to last house on road.

SUBDIVISION CL+T BLOCK / SECTION 8 LOT LOT AREA Existy SITE CLASS. DESIGN FLOW L.T.A.R.

Septic Tank: Existy Gallons; STB Date

Pump Tank: Gallons; PT Date

Pump Make: Model Serial No.

Nitrification Field: No Fields 1 Square Feet 1000 Linear Feet 300

No Lines 3 Trench Width 10-11' Max Trench Bottom Depth 48" Gravel Depth 12-14"

☐ New System X Repair System Type: I, II, III, IV, V, VI

System Description: Bed System - Repair

Repair System Description: Same

Maintenance Agreement Required: ☐ Yes X No

X House/Mod. Home No. Bedrooms 3

☐ Mobile Home No. Bathrooms 2

☐ Business No. Employees

☐ Other


☐ Slab X Crawl Space ☐ Basement w/plumbing ☐ Basement wo/plumbing

Water Supply: X Individual ☐ Community ☐ Public

Comments:

Comments: Repair square footage not with 1/2 original drainfield and 1/2 new drainfield. Very tight site location - Original field was bedrocked above the step down that was found.

INITIAL SITE SKETCH

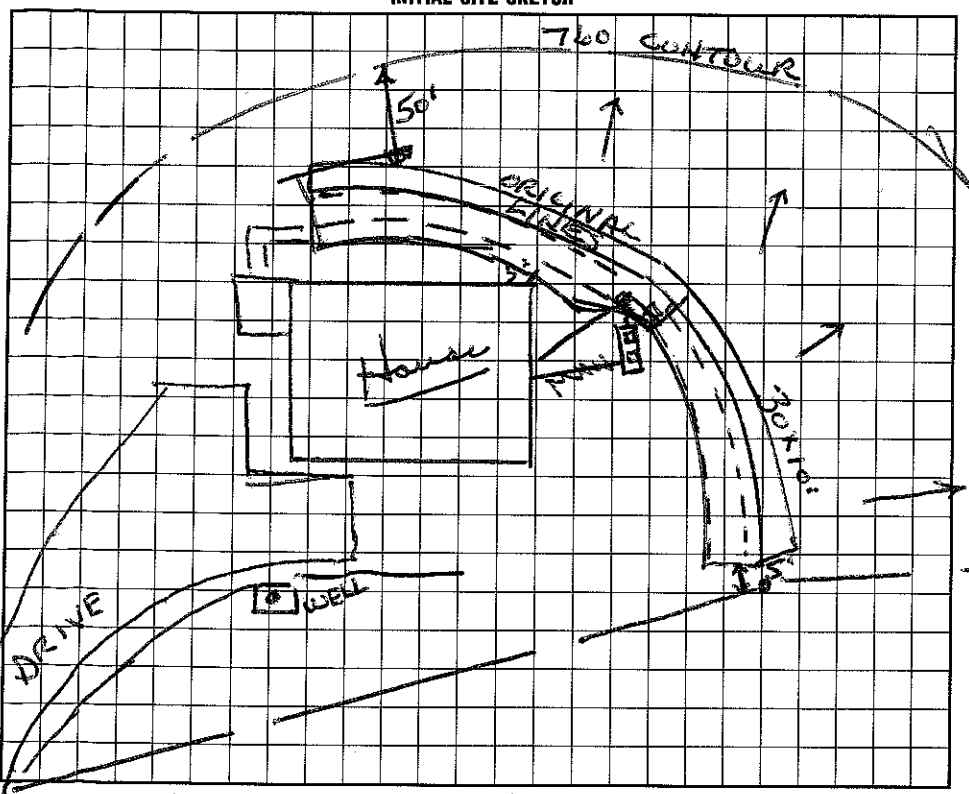

AS BUILT SKETCH

Ans

I understand that this permit can be suspended or revoked if any false information is supplied toward securing the permit/any unauthorized changes are made to the site/any unauthorized changes are made in the installation of the system.

Signed: X Allen N. Rogers

Improvement Permit by: date

Certificate of Completion by: date

Operation Permit by: Wesley Sparks R.S. date 1/24/97

Existing System Inspection by: Wesley Sparks R.S. date 1/3/97

Installed by: F J Ennis

HEALTH DEPT. COPY: WHITE INSPECTION COPY (FINAL): GREEN OWNER COPY (FINAL): YELLOW INSPECTION COPY (INITIAL): PINK OWNER COPY (INITIAL): GOLD