IREDELL COUNTY HEALTH DEPARTMENT

Statesville Office (704) 878-5305 Mooresville Office (704) 660-3625 PERMIT # 203376

IMPROVEMENT PERMIT / AUTHORIZATION TO CONSTRUCT / OPERATION PERMIT / EXISTING SYSTEM

PIN # 4627-50-3752

APPLICANT: Amy Gordon APPLICANT ADDRESS: 121 Langdon Rd. - Mooresville

SITE ADDRESS: Same PHONE: 704-577-1727 ALT. PHONE:

SITE DIRECTIONS: BSR, McKendree, TR Digh, TR Langdon, C end

SUBDIVISION: CLET SECTION: 8 LOT # 395 LOT AREA: .77AC DESIGN FLOW: 480 L.T.A.R.: .3

Septic Tank 1000/500 (gal) STB INFILTRATOR Date PT 20961705

Pump Tank 1000/1500 (gal) PT INFILTRATOR Date PT 20961705

Pump Make LIBERTY Model FL16ZA Serial #

Nitrification Fields 1 # Lines 3 Linear Ft: 400'

Trench Width 36" Max. Trench Bottom Depth 36" Gravel Depth

☒ New System ☐ Repair ☐ Expansion System Type: I II III IV V VI

System Description: PM - 25% Reduction

Repair System Description: Panel Block

Maintenance Agreement Required: ☐ YES ☒ NO ☐ GRAVITY ☒ PRESSURE

☒ Residence No. Bedrooms 4

☐ Business No. Persons

☐ Other No. Employees

☐ Slab ☐ Crawl Space

☒ Basement w/plumbing ☐ Basement w/o plumbing

Water Supply: ☒ Private ☐ Public ☐ Community

Comments / Conditions: Checked Tanks, Drain Field, Supply Line

INITIAL SITE SKETCH

Off site septic system

See Attached Plan

1 From

Piedmont Design

&

Michael Athanas

&

Associates

AS BUILT SKETCH

Installed 3@1341

Set PH

Checked Elec. & Alarm

RA 12-15-15

Permit can be suspended or revoked if any false information is supplied toward securing the permit / any unauthorized changes are made to the site / any unauthorized changes are made in the installation of the system. **CONTACT A LOCATOR SERVICE PRIOR TO ANY EXCAVATION**


☐ **IMPROVEMENT PERMIT** *with plat valid without expiration.* ☒ **IMPROVEMENT PERMIT** *with site plan valid for 60 mos.* ☒ **AUTHORIZATION TO CONSTRUCT** *valid for period equal to IMPROVEMENT PERMIT--not to exceed 60 mo.*

Owner / Applicant Signature: Date: 3/24/15 Installed by: Abernathy

IMPROVEMENT PERMIT by: Date: APPROVED MAR 24 2015 OPERATION PERMIT by: Date: 12-15-15

AUTHORIZATION TO CONSTRUCT by: Date: APPROVED MAR 24 2015 Existing System Inspected by: Date:

Health Dept. Copy - WHITE Applicant (Final Approval) - YELLOW Applicant (Conditional Approval) - PINK

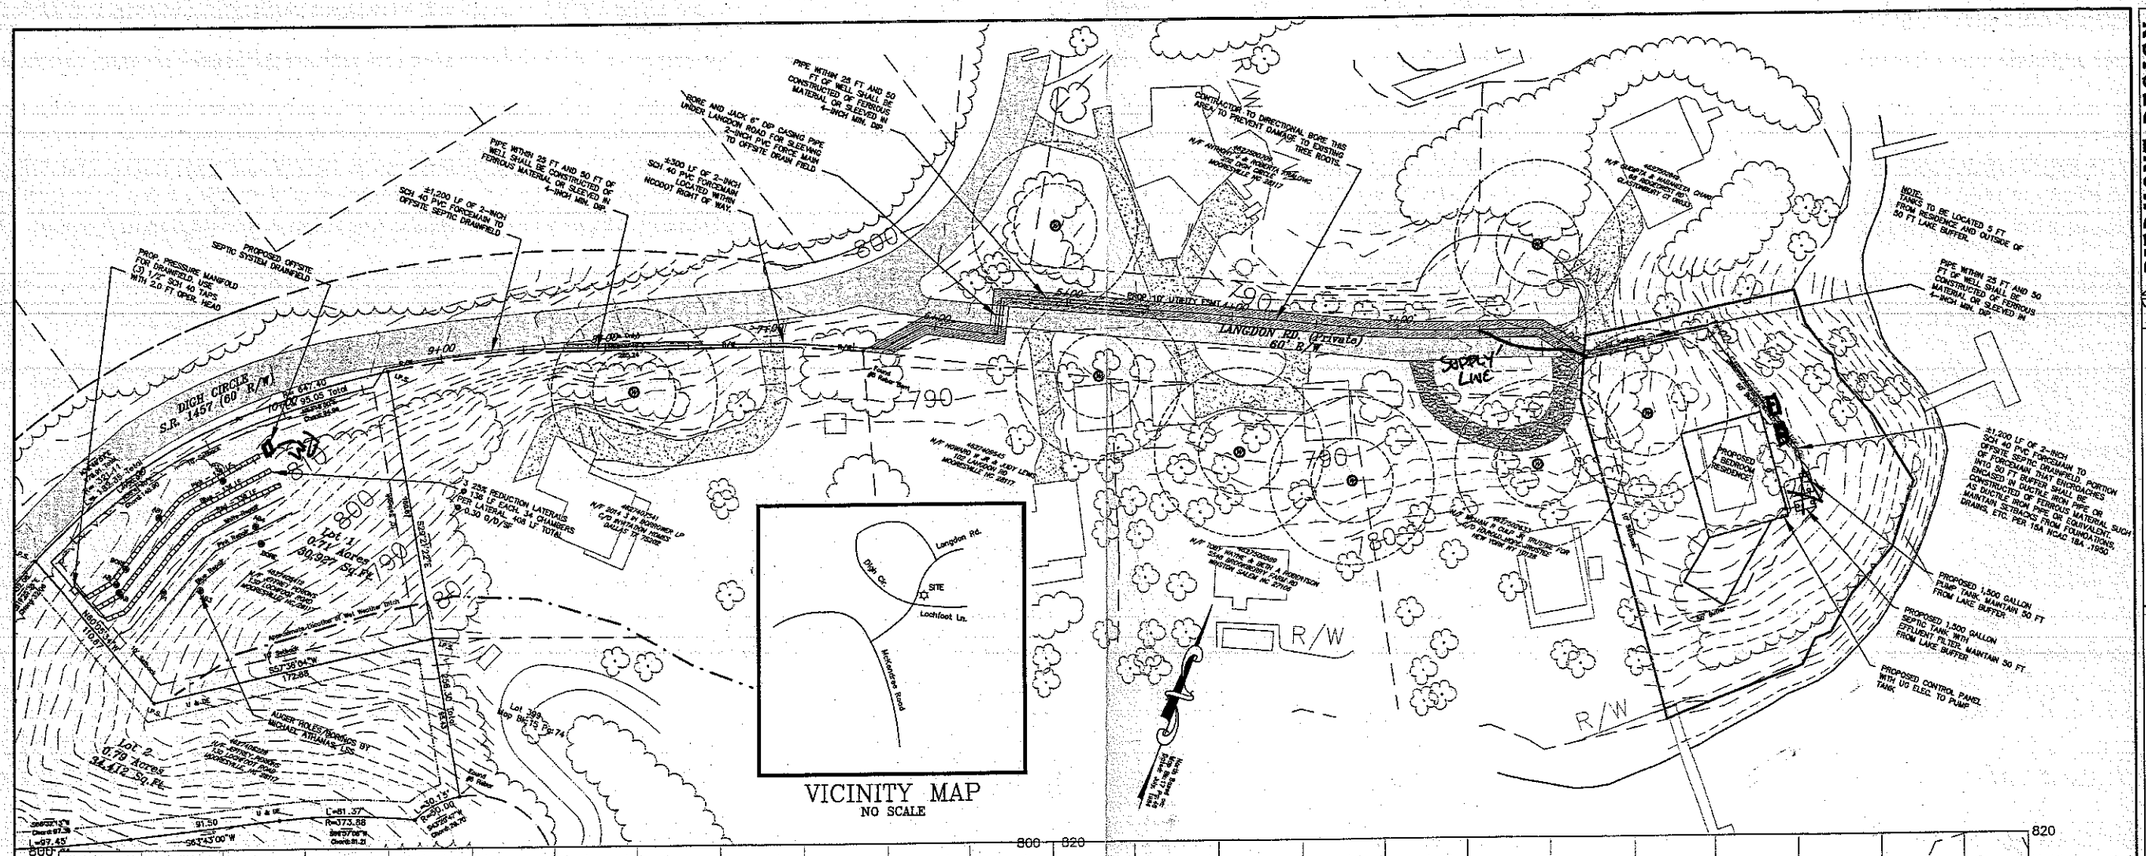

PREPARED FOR:
Todd & Amy Gordon
447 Glencrest Drive
Stanley, NC 28164
(704) 577-1727

PIEDMONT DESIGN ASSOCIATES
Engineering • Surveying • Planning
Associates, P.A.
Suite 101 Westfield Center, 125 East Plaza Drive
Mooresville, North Carolina 28115
Phone:(704) 664-7881 Fax:(704) 664-1778 www.pdapa.com
NCBELS Licensure #: C-1907

Offsite Septic System Site Plan
4 Bedroom Residence
121 Langdon Road
Mooresville, Iredell County, North Carolina

REVISIONS	BY
REV. PER COMMENTS BY IREDELL CO. HEALTH DEPT. & ALMEDGE (2/6/15)	DMD

Date: 1/22/15
Scale: 1"=40 Ft
2' Contours
Drawn: DMD
Checked: DLM
Project: 2014-12-06-EC
Job: 2014-12-06-EC
Sheet
U-1
A 2/6/15
of 3 Sheets

PUBLICATION OR REUSE OF THESE DRAWINGS OR ANY DETAILS WITHIN MUST BE WITH THE WRITTEN CONSENT OF PIEDMONT DESIGN ASSOCIATES, P.A.

Owner: _____ Approved: _____ Date of Issue: _____