IREDELL COUNTY HEALTH DEPARTMENT

STATESVILLE 704-878-5305 MOORESVILLE 704-664-5281

IMPROVEMENT PERMIT / CERTIFICATE OF COMPLETION / OPERATION PERMIT / EXISTING SYSTEM INSPECTION

(11:00) 3rd

PROPERTY DESCRIPTION NO. 22959 DATE Jan. 16, '96 TAX MAP NO. 2L2A 427C 4627509143 Watershed: ✓ Yes ☐ No W54CA

OWNER OR CONTRACTOR Crescent Resources, Inc (Moser Bro) PHONE: Business _____ Home _____

ADDRESS PO Box 1003, Charlotte

LOCATION Brawley Sch Rd. TR McKendree TR Grasshopper Lot @ corner w/ Rhinehill Ln - septic AREA ACROSS STREET

SUBDIVISION Crescent/LN BLOCK / SECTION 3 LOT 1580 LOT AREA 25'X132' septic lot SITE CLASS. BSpan.1456 DESIGN FLOW 360gpd L.T.A.R. .3

Septic Tank: 1000 Gallons; STB Brantley Date 427C

Pump Tank: 1000 Gallons; PT _____ Date _____

Pump Make: _____ Model _____ Serial No. _____

Nitrification Field: No. Fields 1 Square Feet 900 Linear Feet 300

No. Lines 4@75' Trench Width 36" Max Trench Bottom Depth 36" Gravel Depth N/A

✓ New System ☐ Repair System Type: I, II, III, IV, V, VI

System Description: pumped - gravity - Infiltrator

Repair System Description: LP panel

Maintenance Agreement Required: ☐ Yes ✓ No initially

✓ House/Mod. Home No. Bedrooms 3

☐ Mobile Home No. Bathrooms 2

☐ Business No. Employees _____

☐ Other _____

☐ Slab ☐ Crawl Space ✓ Basement w/plumbing ☐ Basement wo/plumbing


Water Supply: ✓ Individual ☐ Community ☐ Public

Comments:


Comments:

1"=100'

INITIAL SITE SKETCH

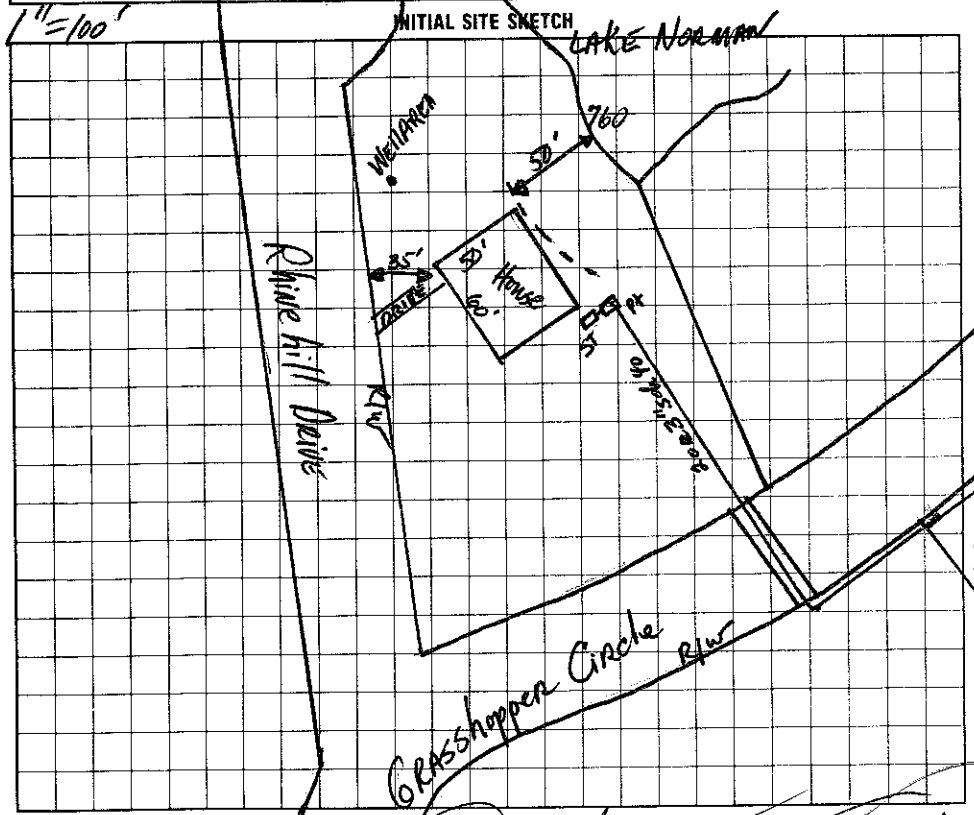

AS BUILT SKETCH

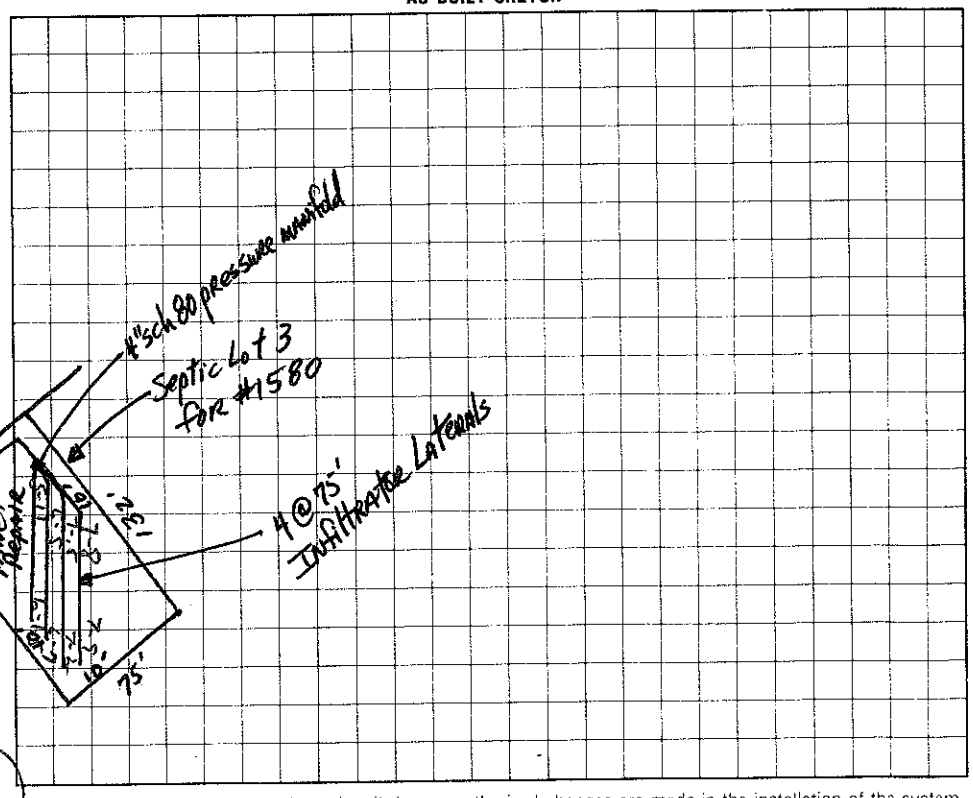

I understand that this permit can be suspended or revoked if any false information is supplied toward securing the permit/any unauthorized changes are made to the site/any unauthorized changes are made in the installation of the system.

Signed: _____

Improvement Permit by: Jayne R. Johnson, RS date Jan 16, '96

Existing System Inspection by: C. [illegible] date 7/12/96

Installed by: Moser Bro.

Certificate of Completion by: _____ date _____

Operation Permit by: C. [illegible] date 7/20/96

Construction Authorization

HEALTH DEPT. COPY: WHITE INSPECTION COPY (FINAL): GREEN OWNER COPY (FINAL): YELLOW INSPECTION COPY (INITIAL): PINK OWNER COPY (INITIAL): GOLD