IREDELL COUNTY HEALTH DEPARTMENT

STATESVILLE 704-878-5305 MOORESVILLE 704-664-5281

IMPROVEMENT PERMIT / AUTHORIZATION TO CONSTRUCT / OPERATION PERMIT / EXISTING SYSTEM INSPECTION

PERMIT# 086767 PIN# 4627-50-9753

OWNER OR CONTRACTOR Luther M. Adams DATE 1/13/00

ADDRESS 615 Dalloway Dr. Fayetteville, NC. 28303 PHONE: Business — Home 664-3576

LOCATION 1100 TR McKendree TR Grasshopper Cir, (L) fork TL Passage Ct. then (L) to water — 117 Passage Ct.

SUBDIVISION CL+T BLOCK / SECTION 8 LOT 434 LOT AREA .73Ac. SITE CLASS PS DESIGN FLOW 360 L.T.A.R. .3

Septic Tank: EXISTING Gallons: STB 1007 Date 7/30/03

Pump Tank: GRINDER PUMP Gallons: PT 274 Date 7/23/03

Pump Make: ZOELLER Model C-140-B Serial No. 9/15/63

Nitrification Field: No Fields EXISTING Square Feet 545 Linear Feet

No Lines Trench Width Max Trench Bottom Depth Gravel Depth

☐ New System ☐ Repair System Type: I, II, (III) IV, V, VI

System Description: Adding Grinder Pump

Repair System Description:

Maintenance Agreement Required: ☐ Yes ☒ No

☒ House/Mod. Home No. Bedrooms 2

☐ Mobile Home No. Bathrooms 2.5

☐ Business No. Employees

☐ Other


☐ Slab ☐ Crawl Space ☐ Basement w/plumbing ☐ Basement wo/plumbing

Water Supply: ☒ Individual ☐ Public ☐ Community

Comments:/Conditions:

Comments:/Conditions:

INITIAL SITE SKETCH

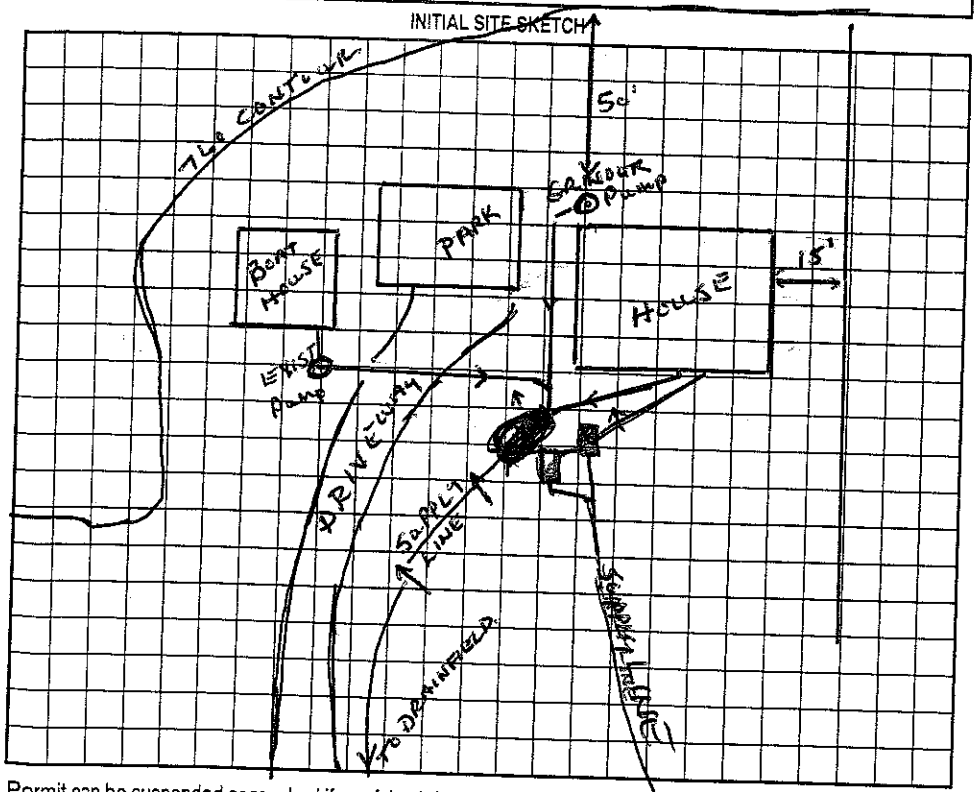

AS BUILT SKETCH

Permit can be suspended or revoked if any false information is supplied toward securing the permit/any unauthorized changes are made to the site/any unauthorized changes are made in the installation of the system. Improvement Permit with plat valid without expiration. Improvement Permit with site plan valid for sixty months. Authorization to Construct is valid for a period equal to that of Improvement Permit – not to exceed sixty months.

Signed: * JM Adams date 1/13/00

Improvement Permit by: Wesley Sparks R.S. date 1/13/00

Authorization to Construct by: Wesley Sparks R.S. date 1/13/00

Installed by: Wayne's Plumbing

Operation Permit by: Wesley Sparks R.S. date 10/2/03

Existing System Inspection by: date

HEALTH DEPT. COPY: WHITE OWNER COPY (FINAL): YELLOW OWNER COPY (INITIAL): PINK