...LL COUNTY HEALTH DEPARTMENT

...TATESVILLE 704-878-5305 MOORESVILLE 704-664-5281

...PROVEMENT PERMIT / ~~CERTIFICATE OF COMPLETION~~ / OPERATION PERMIT / EXISTING SYSTEM INSPECTION

PROPERTY DESCRIPTION NO. 22369 DATE 12/18/95 TAX MAP NO. 2L 2A 383 Watershed: [X] Yes [ ] No

OWNER OR CONTRACTOR Willard Clark PHONE: Business - 4627514835 Home

ADDRESS 4247 Lake Cliff Dr. Clemmons, NC 27012

LOCATION Brew Sch TR McLendon TR Dighlin TR Chester Rd., to last lot on ©

SUBDIVISION CL+T BLOCK / SECTION 8 LOT 383 LOT AREA 165x210 SITE CLASS. PS DESIGN FLOW 480 L.T.A.R. .3

Septic Tank: 1000 Gallons; STB 794 Date 12/21/95

Pump Tank: ____ Gallons; PT ____ Date ____

Pump Make: ____ Model ____ Serial No. ____

Nitrification Field: No Fields 1 Square Feet ____ Linear Feet 160*

No Lines 2 Trench Width 24 Max Trench Bottom Depth 36" Gravel Depth 6" Stone

[X] New System [ ] Repair System Type: I, II, III, IV, V, VI

System Description: 16" Prefab Panels

Repair System Description: ____

Maintenance Agreement Required: [ ] Yes [X] No

[X] House/Mod. Home No. Bedrooms 4

[ ] Mobile Home No. Bathrooms 4

[ ] Business No. Employees ____

[ ] Other ____


[ ] Slab [ ] Crawl Space [X] Basement w/plumbing [ ] Basement wo/plumbing

Water Supply: [X] Individual [ ] Community [ ] Public


Comments: ~~X~~ 16" Prefab. Panels Addition to Existing System Well not 25' from foundation as should be

Comments: Owner Because of this. Rec's.

INITIAL SITE SKETCH

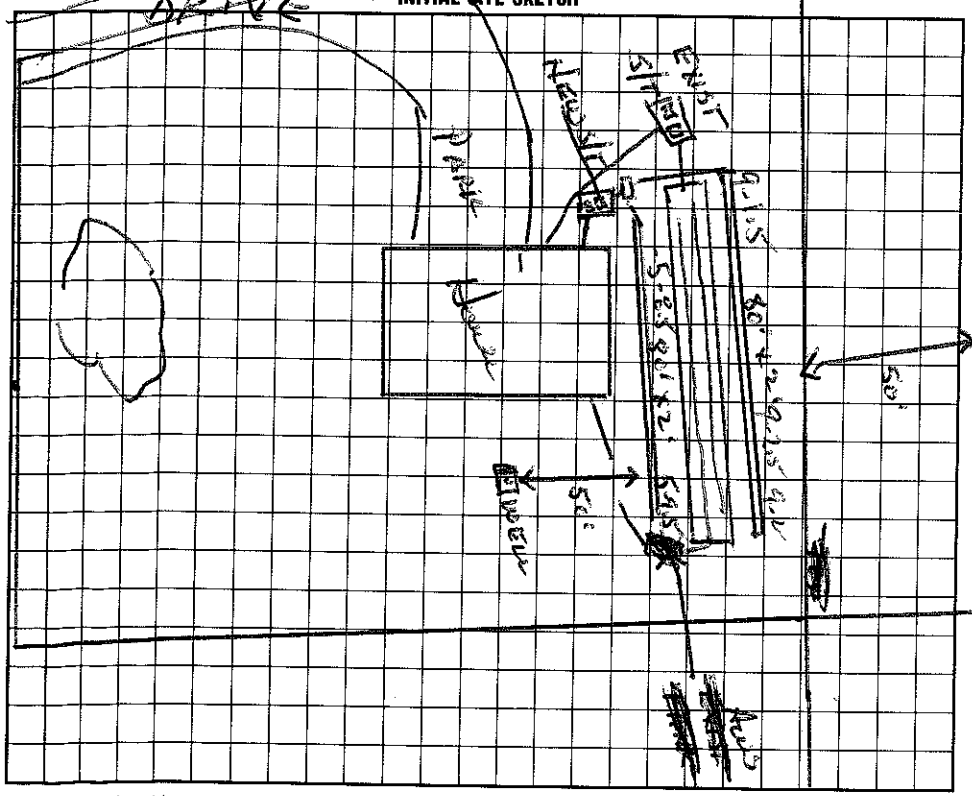

AS BUILT SKETCH

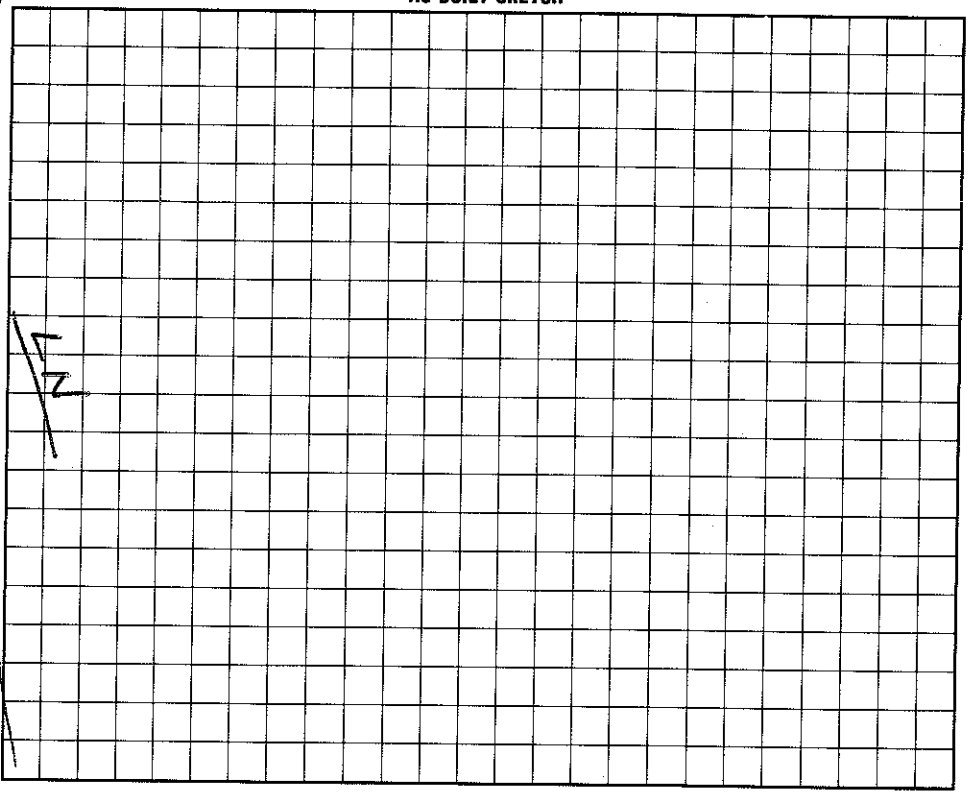

I understand that this permit can be suspended or revoked if any false information is supplied toward securing the permit/any unauthorized changes are made to the site/any unauthorized changes are made in the installation of the system.

Signed: X Tommy A Parker, CPSS Agent

Improvement Permit by: Wesley Sparks R.S. date 12/18/95

Existing System Inspection by: Environmental Health Specialist Wesley Sparks R.S. date 12/18/95

Installed by: Richard Abernathy

Certificate of Completion by: Wesley Sparks R.S. date 2/23/96

Operation Permit by: Wesley Sparks R.S. date 2/23/96

HEALTH DEPT. COPY: WHITE INSPECTION COPY (FINAL): GREEN OWNER COPY (FINAL): YELLOW INSPECTION COPY (INITIAL): PINK OWNER COPY (INITIAL): GOLD