IREDELL COUNTY HEALTH DEPARTMENT

Statesville Phone TR 3-7271 Mooresville Phone No. 664-5281

PERMIT TO INSTALL SEPTIC TANK

Permit No. 162 Permit Date 7 - 3 - 1973

Owner Barbara Jarrett Address Charlotte

Installed By F. J. Ervin Address Mooresville


Location of Property 150 west Thon 1211 at end Take dirt st. To right at end.

Tank		Capacity		Length of Lines		Fixtures	
Block	( )	1000	(✓)	225'	(✓)	No. of Baths	(2
Precast	(✓)	1250	( )	250'	( )	Dishwasher	(no
		1500	( )	Other		Garbage Grdr.	(no
		Other				Other Washing Machine	

NOTIFY HEALTH DEPARTMENT AT LEAST EIGHT HOURS BEFORE TANK IS TO BE INSPECTED.

Final Inspection 7 - 3 - 1973 Approved (✓) Disapproved ( )

Remarks

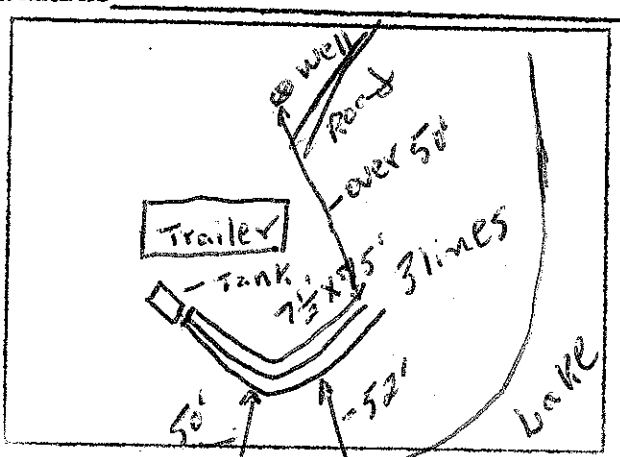

Sketch of Installation

J. C. Moore

Sanitarian